




ENGINEER'S CERTIFICATION
 "I MATTHEW BEGGIS BEING A CONSULTING ENGINEER AND DULY AUTHORIZED REPRESENTATIVE OF EMPOWER ENGINEERS AND PROJECT MANAGERS HEREBY:-
 • CERTIFY THE INFORMATION CONTAINED IN THIS DRAWING IS AN ACCURATE 'AS CONSTRUCTED' REPRESENTATION OF THE WORKS; AND
 • ACCEPT RESPONSIBILITY FOR THE 'AS CONSTRUCTED' INFORMATION CONTAINED IN THIS DRAWING."
 RPEQ: 5555
 11/10/17
 FOR: EMPOWER ENGINEERS AND PROJECT MANAGERS PTY LTD

I,Peter.....Slippel..... being a cadastral surveyor and duly authorised representative of Queensland Surveyors Pty Ltd hereby:
 • certify the information contained in this drawing is an accurate as constructed representation of the works
 • accept responsibility for the as constructed information contained in this drawing
 • acknowledge the as constructed information contained in the drawing may be relied on by council and others
 Certification by*P. Slippel*..... on 8/8/2017
 (Signature) (Date)
 for Queensland Surveyors Pty Ltd

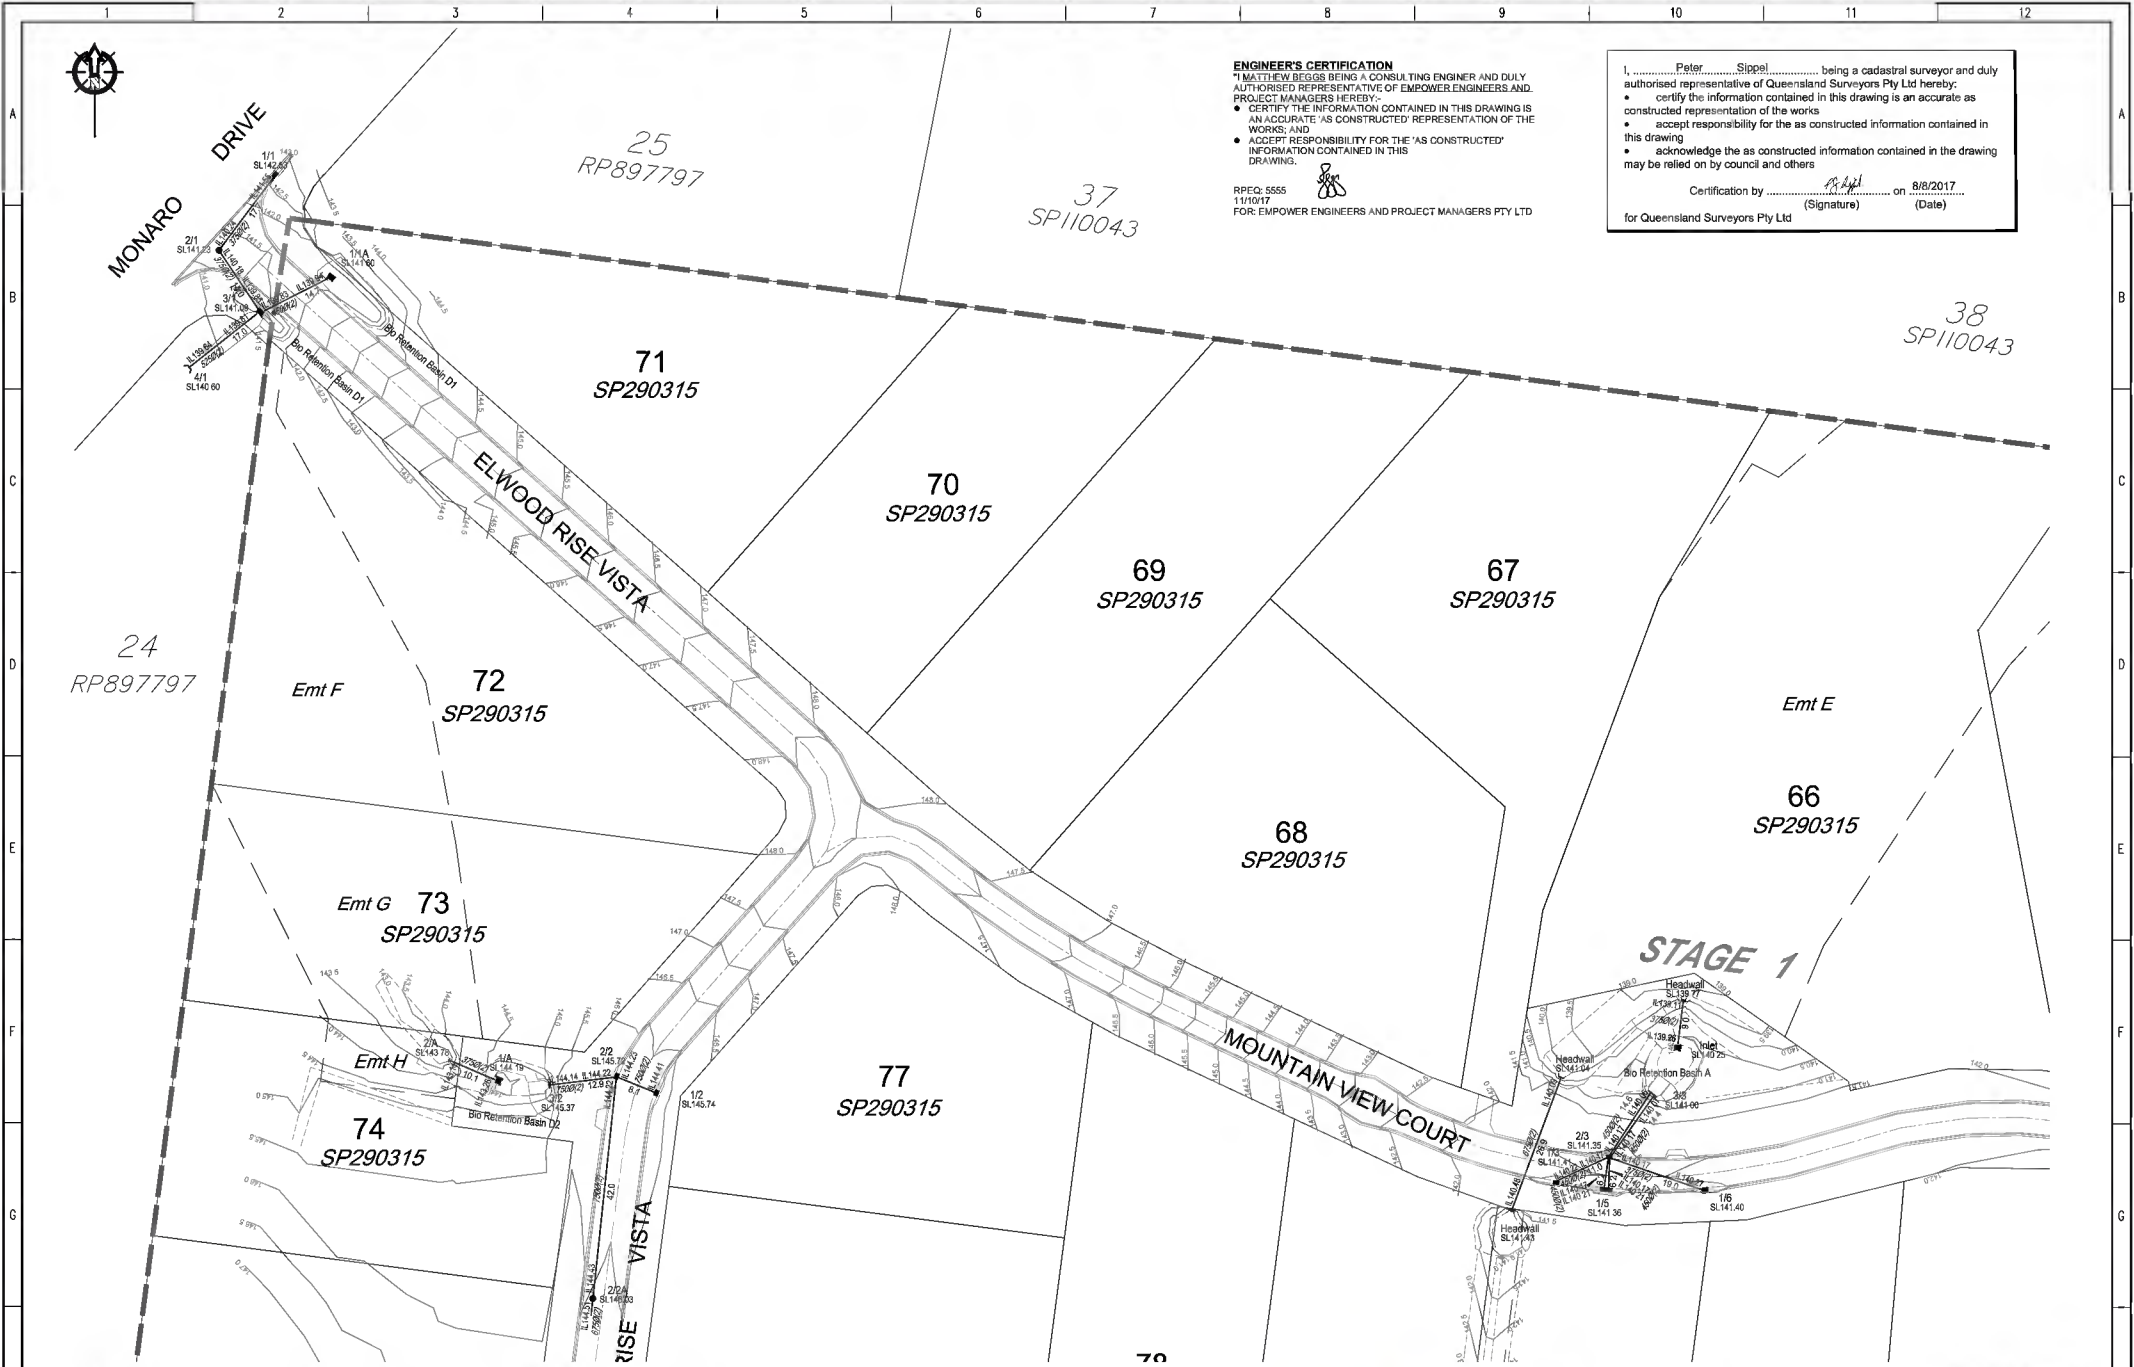

DRAWING REVISIONS		REFERENCE DRAWINGS		DESIGN FILE No.		DESIGNED	
REV.	REVISION DESCRIPTION	DRG. No.	DESCRIPTION	CONSTRUCT. No.	DATE	DATE	EJM
A	Original			31407 ASW01	8/8/2017	8/8/2017	EJM
				LOG BOOK			EJM
				LEVEL DATUM	AHD		
				DATUM			

THIS WORK WAS PREPARED BY:
QUEENSLAND SURVEYING PTY LTD
 SCALE 1:500 ORIGINAL SIZE A1

Moreton Bay Regional Council
 CABOOLTURE DISTRICT OFFICE
 2 BASKING STREET CABOOLTURE QLD 4510
 PO BOX 159 CABOOLTURE QLD 4510
 Telephone: (07) 5433 8100
 Fax: (07) 5433 4099

STAGE 1, ELWOOD RISE, D'AUGILAR AS CONSTRUCTED STORMWATER

MBRC SUBDIVISION REFERENCE	
DA/29768/2015/V3RL	
No. 1 OF 3 PLANS	REV.
ASCON GRID NUMBER	
31407-ASW01	A




ENGINEER'S CERTIFICATION
 I, MATTHEW BEGGIS BEING A CONSULTING ENGINEER AND DULY AUTHORIZED REPRESENTATIVE OF EMPOWER ENGINEERS AND PROJECT MANAGERS HEREBY:-
 • CERTIFY THE INFORMATION CONTAINED IN THIS DRAWING IS AN ACCURATE 'AS CONSTRUCTED' REPRESENTATION OF THE WORKS; AND
 • ACCEPT RESPONSIBILITY FOR THE 'AS CONSTRUCTED' INFORMATION CONTAINED IN THIS DRAWING.

RPEG: 5555
 11/10/17
 FOR: EMPOWER ENGINEERS AND PROJECT MANAGERS PTY LTD

I,Peter.....Slippel..... being a cadastral surveyor and duly authorised representative of Queensland Surveyors Pty Ltd hereby:
 • certify the information contained in this drawing is an accurate as constructed representation of the works
 • accept responsibility for the as constructed information contained in this drawing
 • acknowledge the as constructed information contained in the drawing may be relied on by council and others

Certification by*P. Slippel*..... on 8/8/2017
 (Signature) (Date)

for Queensland Surveyors Pty Ltd

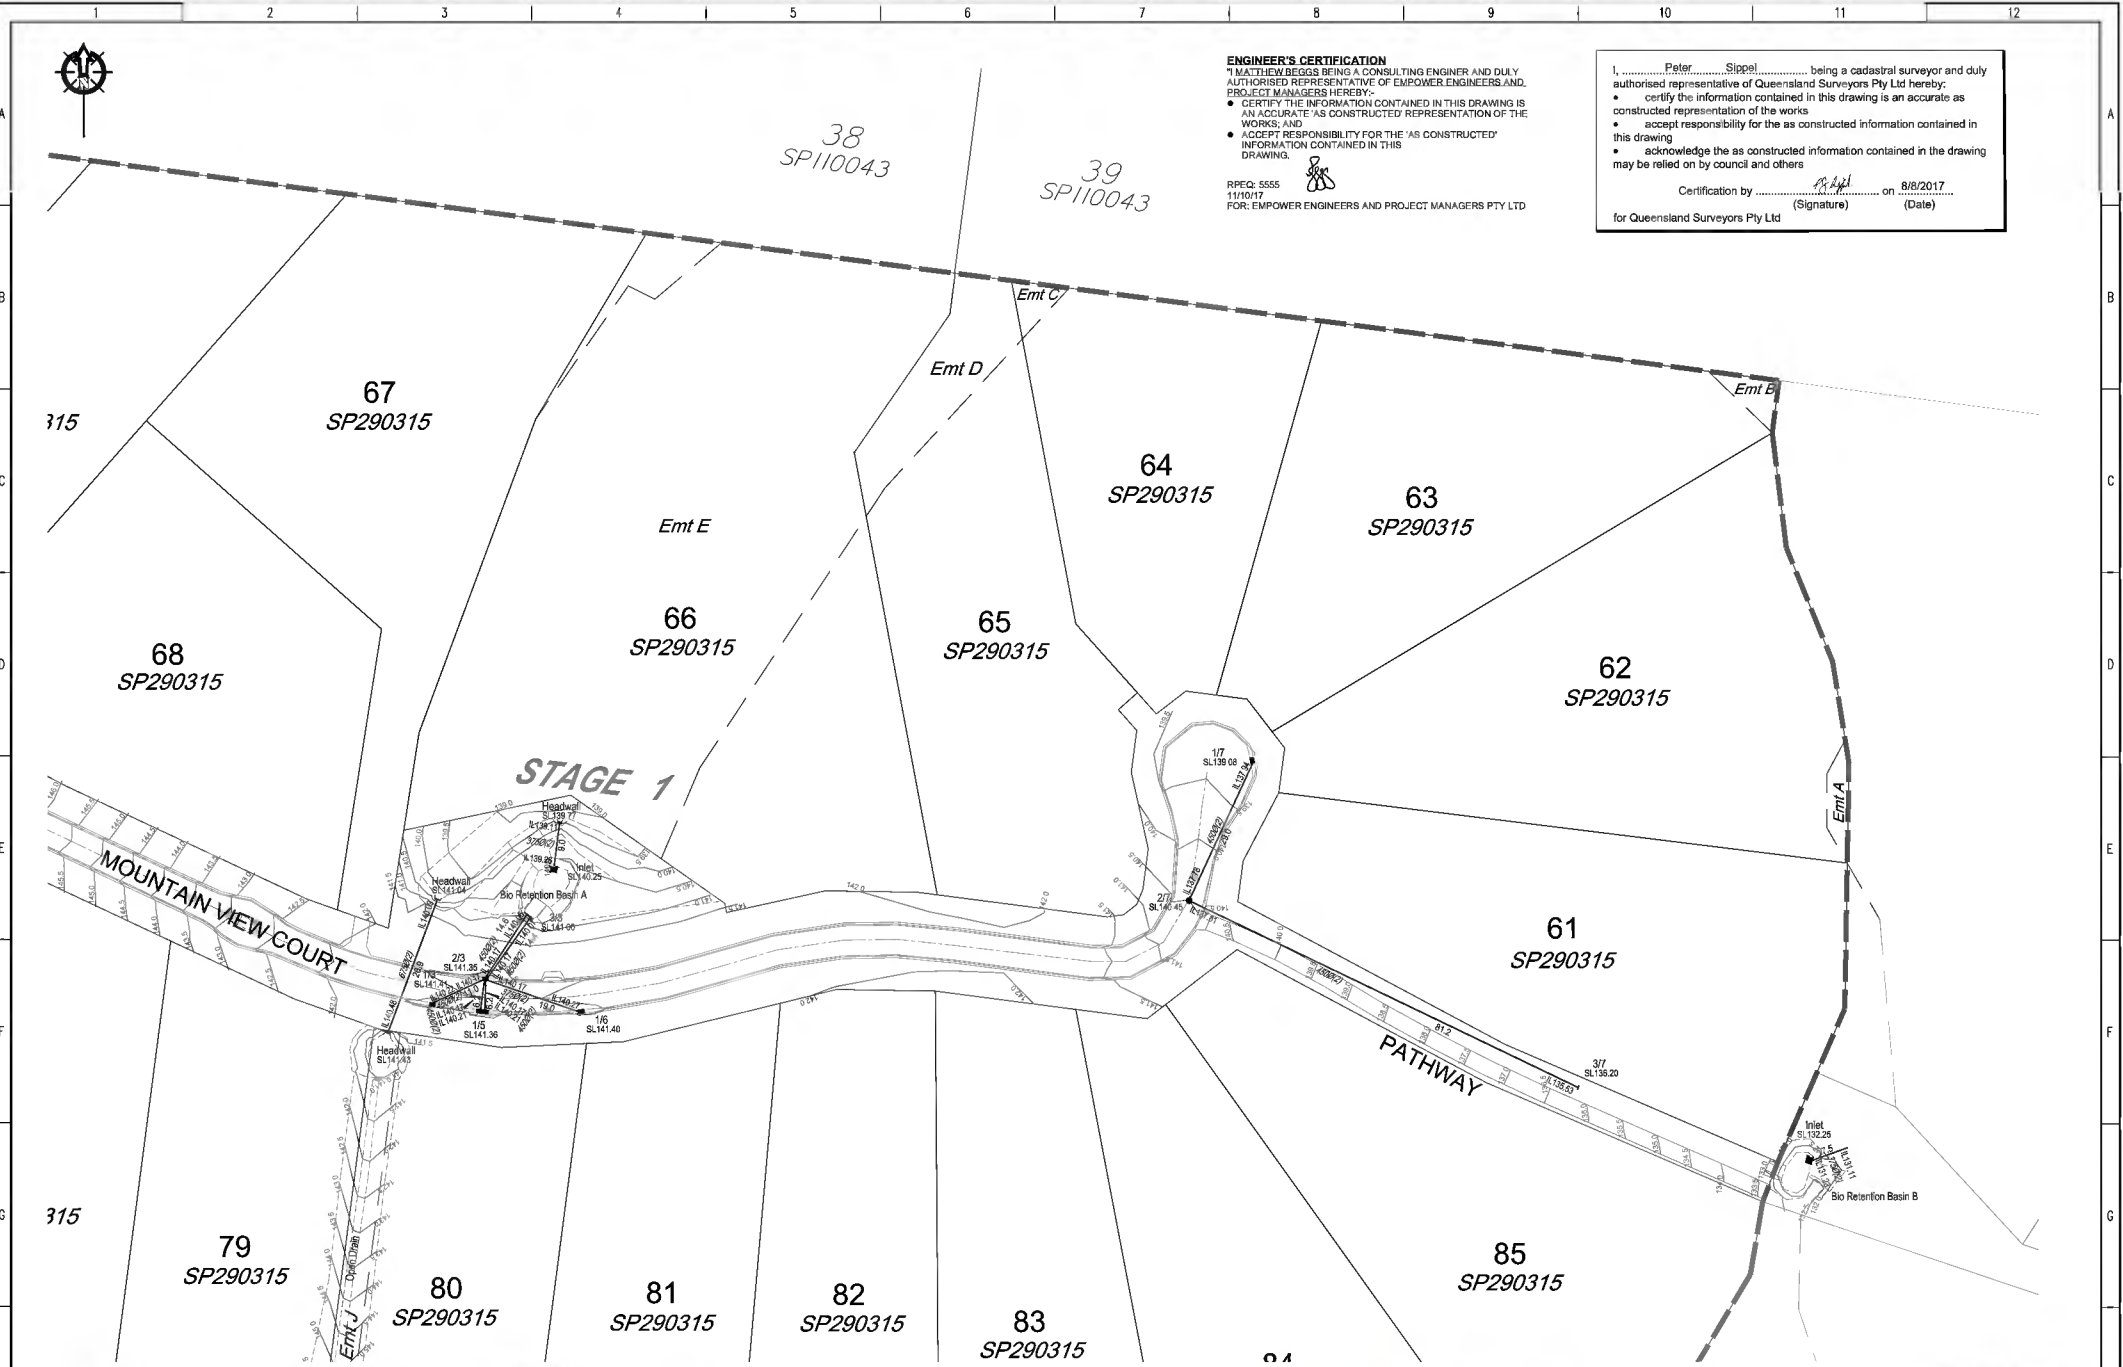

DRAWING REVISIONS	
REV.	REVISION DESCRIPTION
A	Original

REFERENCE DRAWINGS	
DRG. No.	DESCRIPTION

DESIGN FILE No.	
CONSTRUCT.	No.

THIS WORK WAS PREPARED BY:
QUEENSLAND SURVEYING PTY LTD

SCALE 1:500 ORIGINAL SIZE A1

Moreton Bay Regional Council

MORRISON DISTRICT OFFICE
 2 HASKING STREET CABOOLTURE QLD 4510
 PO BOX 159 CABOOLTURE QLD 4510
 Telephone: (07) 5433 8100
 Fax: (07) 5433 4000

STAGE 1, ELWOOD RISE, D'AUGILAR AS CONSTRUCTED STORMWATER

MORC SUBDIVISION REFERENCE	
No.	REV.
2	A

