




ENGINEER'S CERTIFICATION
 I, MATTHEW BEGGIS BEING A CONSULTING ENGINEER AND DULY AUTHORIZED REPRESENTATIVE OF EMPOWER ENGINEERS AND PROJECT MANAGERS HEREBY:-
 • CERTIFY THE INFORMATION CONTAINED IN THIS DRAWING IS AN ACCURATE 'AS CONSTRUCTED' REPRESENTATION OF THE WORKS; AND
 • ACCEPT RESPONSIBILITY FOR THE 'AS CONSTRUCTED' INFORMATION CONTAINED IN THIS DRAWING.

RPEQ: 5555
 11/10/17
 FOR: EMPOWER ENGINEERS AND PROJECT MANAGERS PTY LTD

I,Peter.....Slippel..... being a cadastral surveyor and duly authorised representative of Queensland Surveyors Pty Ltd hereby:
 • certify the information contained in this drawing is an accurate as constructed representation of the works
 • accept responsibility for the as constructed information contained in this drawing
 • acknowledge the as constructed information contained in the drawing may be relied on by council and others

Certification by*P. Slippel*..... on 8/8/2017
 (Signature) (Date)

for Queensland Surveyors Pty Ltd

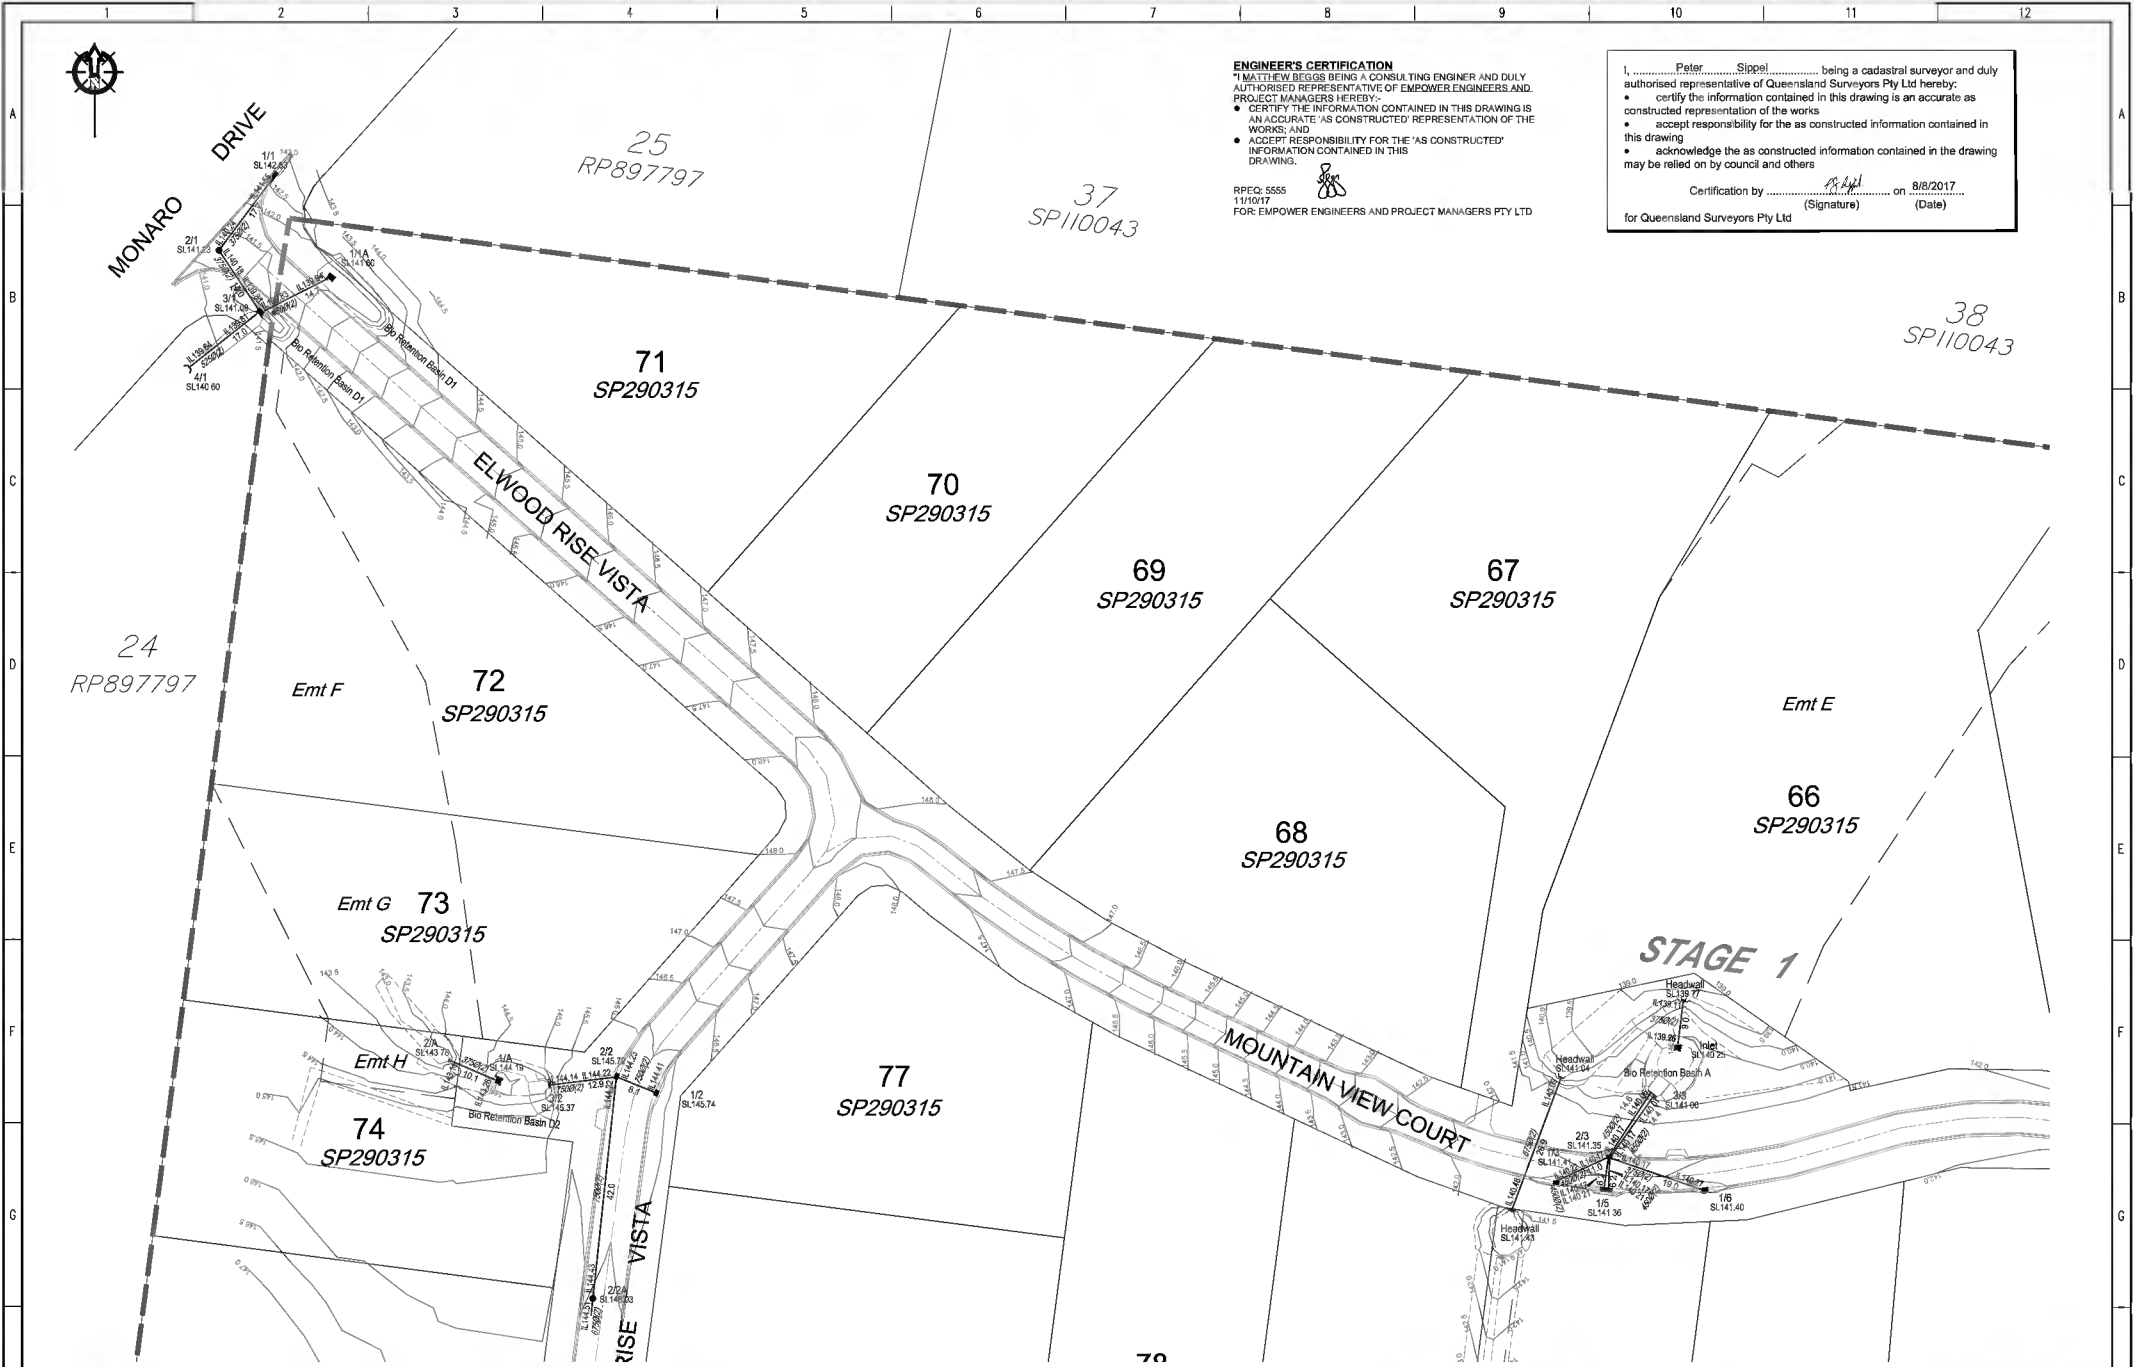

DRAWING REVISIONS		REFERENCE DRAWINGS		DESIGN FILE No.	DESIGNED
REV.	REVISION DESCRIPTION	DRG. No.	DESCRIPTION	CONSTRUCT. No.	DATE
A	Original			31407 ASW01	8/8/2017
				FIELD BOOK	
				LOG BOOK	
				LEVEL DATUM	AHD
				DATUM	


THIS WORK WAS PREPARED BY:
QUEENSLAND SURVEYING PTY LTD

SCALE 1:500 ORIGINAL SIZE A1

MORETON BAY REGIONAL COUNCIL
 CABOOLTURE DISTRICT OFFICE
 2 BASKING STREET CABOOLTURE QLD 4510
 PO BOX 159 CABOOLTURE QLD 4510
 Telephone: (07) 5433 8100
 Fax: (07) 5433 4099

STAGE 1, ELWOOD RISE, D'AUGILAR AS CONSTRUCTED STORMWATER

MBRC SUBDIVISION REFERENCE	
DA/29768/2015/V3RL	
No. 1 OF 3 PLANS	REV.
ASCON GRID NUMBER	
31407-ASW01	A

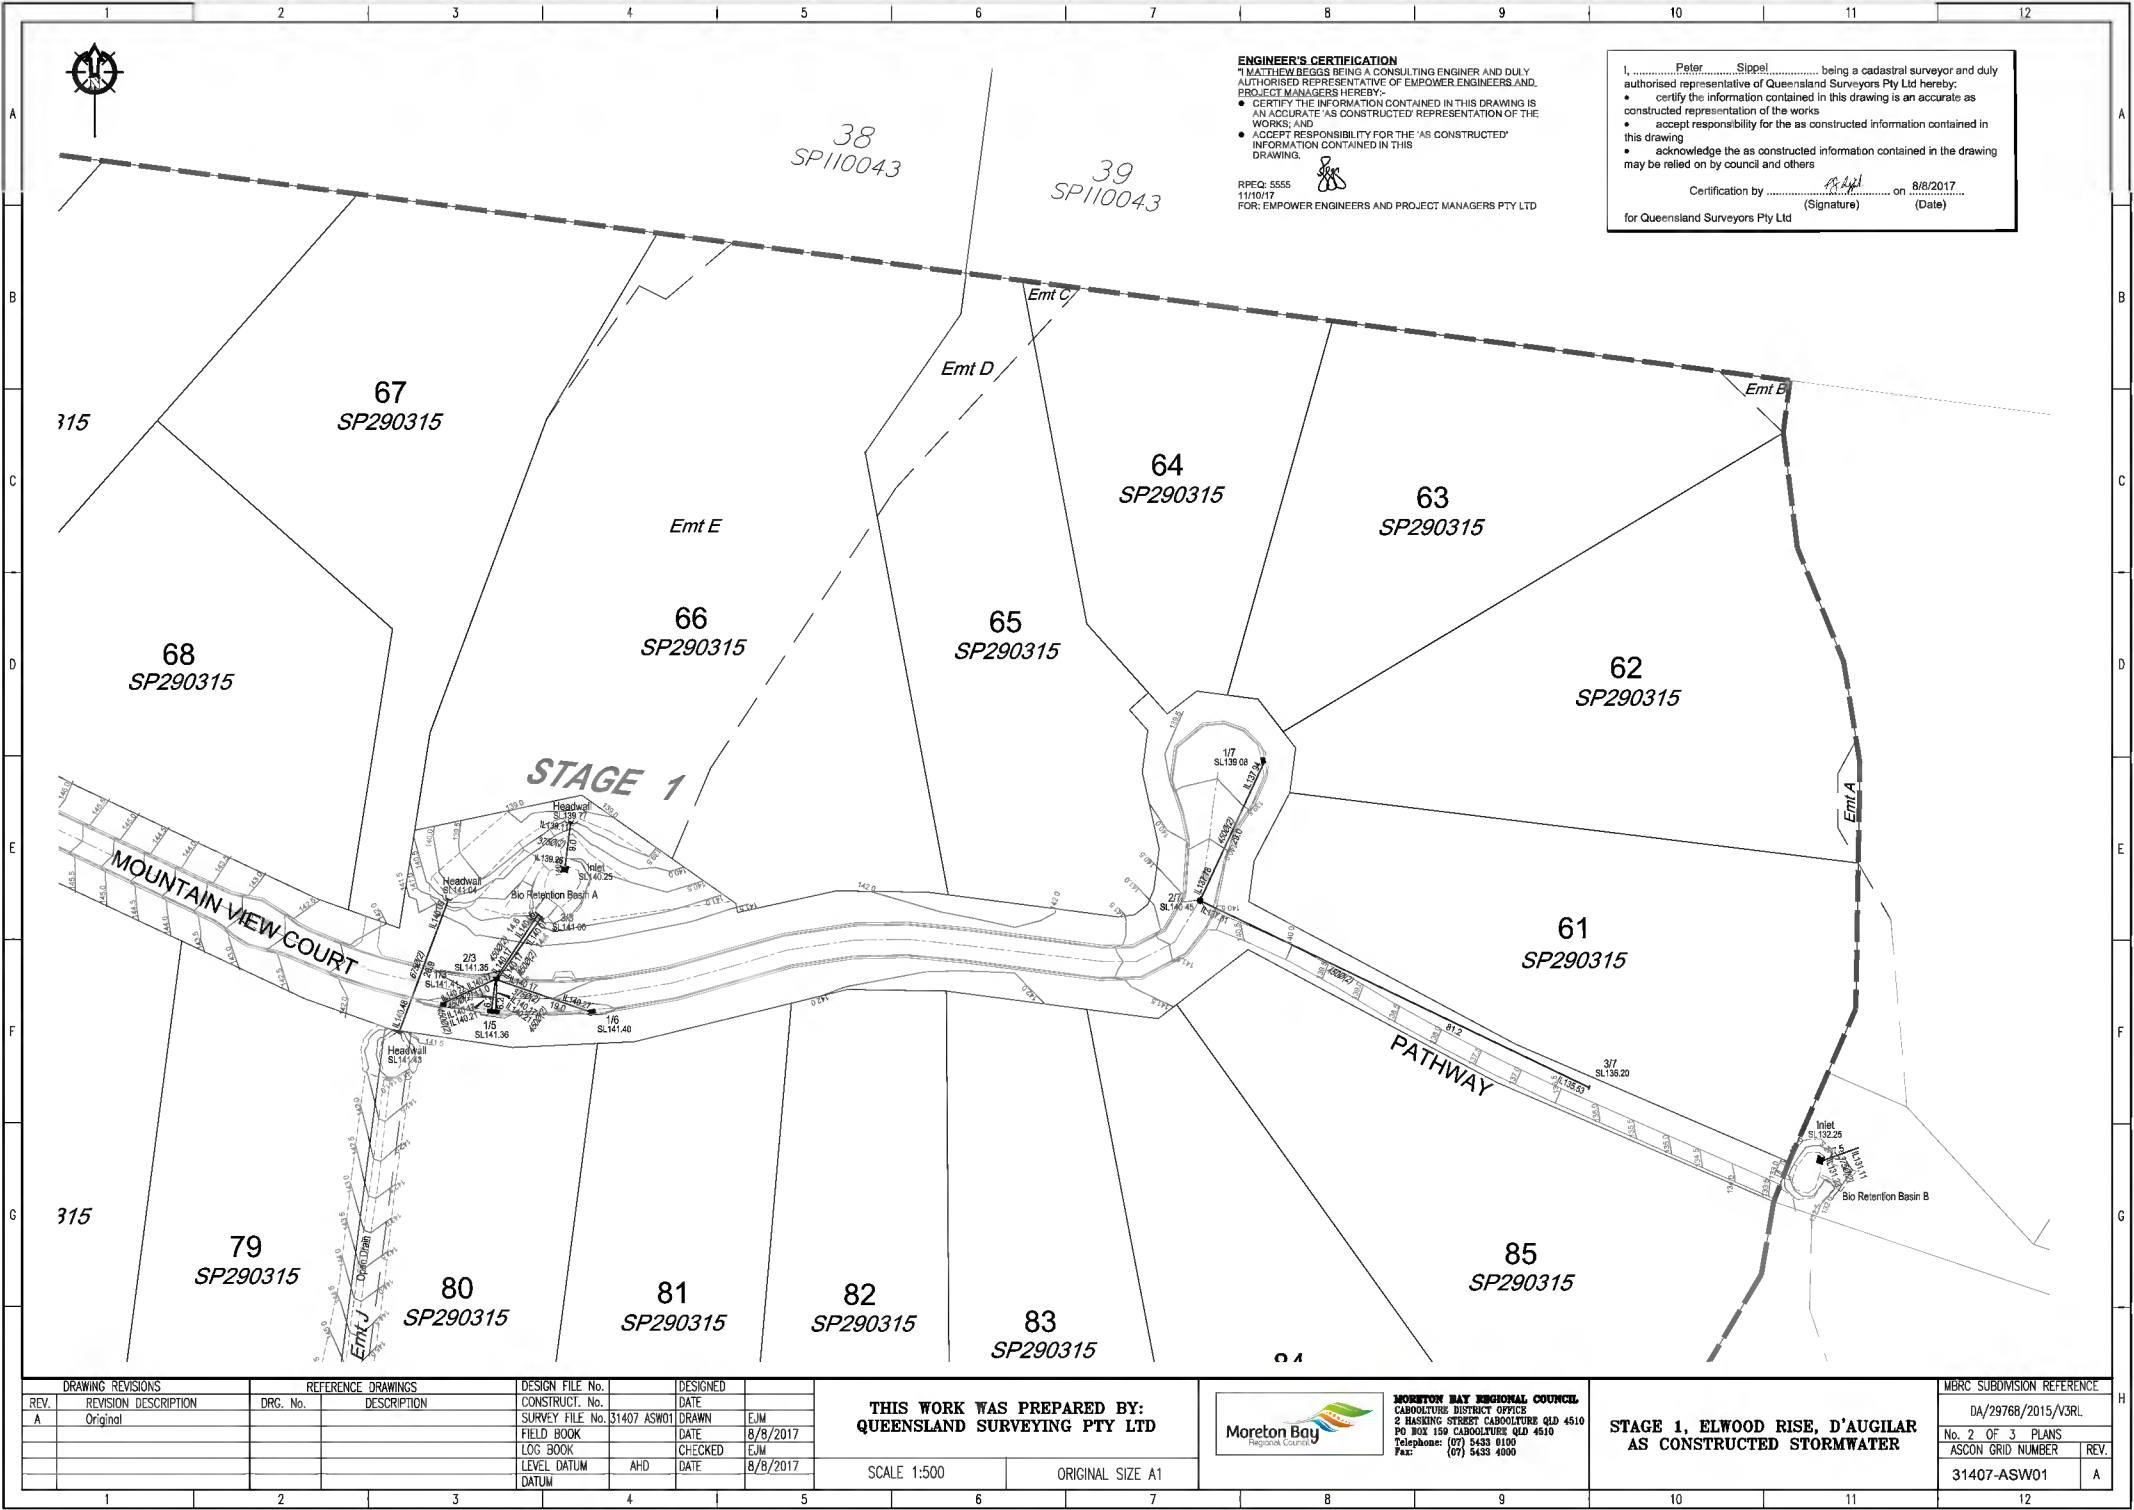

ENGINEER'S CERTIFICATION
 I, MATTHEW BEGGIS BEING A CONSULTING ENGINEER AND DULY AUTHORIZED REPRESENTATIVE OF EMPOWER ENGINEERS AND PROJECT MANAGERS HEREBY:-
 ● CERTIFY THE INFORMATION CONTAINED IN THIS DRAWING IS AN ACCURATE 'AS CONSTRUCTED' REPRESENTATION OF THE WORKS; AND
 ● ACCEPT RESPONSIBILITY FOR THE 'AS CONSTRUCTED' INFORMATION CONTAINED IN THIS DRAWING.

RPEG: 5555
 11/10/17
 FOR: EMPOWER ENGINEERS AND PROJECT MANAGERS PTY LTD

I,Peter.....Slippel..... being a cadastral surveyor and duly authorised representative of Queensland Surveyors Pty Ltd hereby:
 ● certify the information contained in this drawing is an accurate as constructed representation of the works
 ● accept responsibility for the as constructed information contained in this drawing
 ● acknowledge the as constructed information contained in the drawing may be relied on by council and others

Certification by*P. Slippel*..... on 8/8/2017
 (Signature) (Date)
 for Queensland Surveyors Pty Ltd

STAGE 1

MOUNTAIN VIEW COURT

PATHWAY

DRAWING REVISIONS	
REV.	REVISION DESCRIPTION
A	Original

REFERENCE DRAWINGS	
DRG. No.	DESCRIPTION

DESIGN FILE No.	
CONSTRUCT. No.	DATE
31407 ASW01	EJM
FIELD BOOK	DATE 8/8/2017
LOG BOOK	CHECKED EJM
LEVEL DATUM	AHD DATE 8/8/2017
DATUM	

**THIS WORK WAS PREPARED BY:
 QUEENSLAND SURVEYING PTY LTD**


SCALE 1:500 ORIGINAL SIZE A1

Moreton Bay
 Regional Council

MORRISON BAY REGIONAL COUNCIL
 CABOOLTURE DISTRICT OFFICE
 2 HASKING STREET CABOOLTURE QLD 4510
 PO BOX 159 CABOOLTURE QLD 4510
 Telephone: (07) 5433 8100
 Fax: (07) 5433 4000

**STAGE 1, ELWOOD RISE, D'AUGILAR
 AS CONSTRUCTED STORMWATER**

MORC SUBDIVISION REFERENCE	
No. 2 OF 3 PLANS	REV.
DA/29768/2015/V3RL	A
ASCON GRID NUMBER	
31407-ASW01	

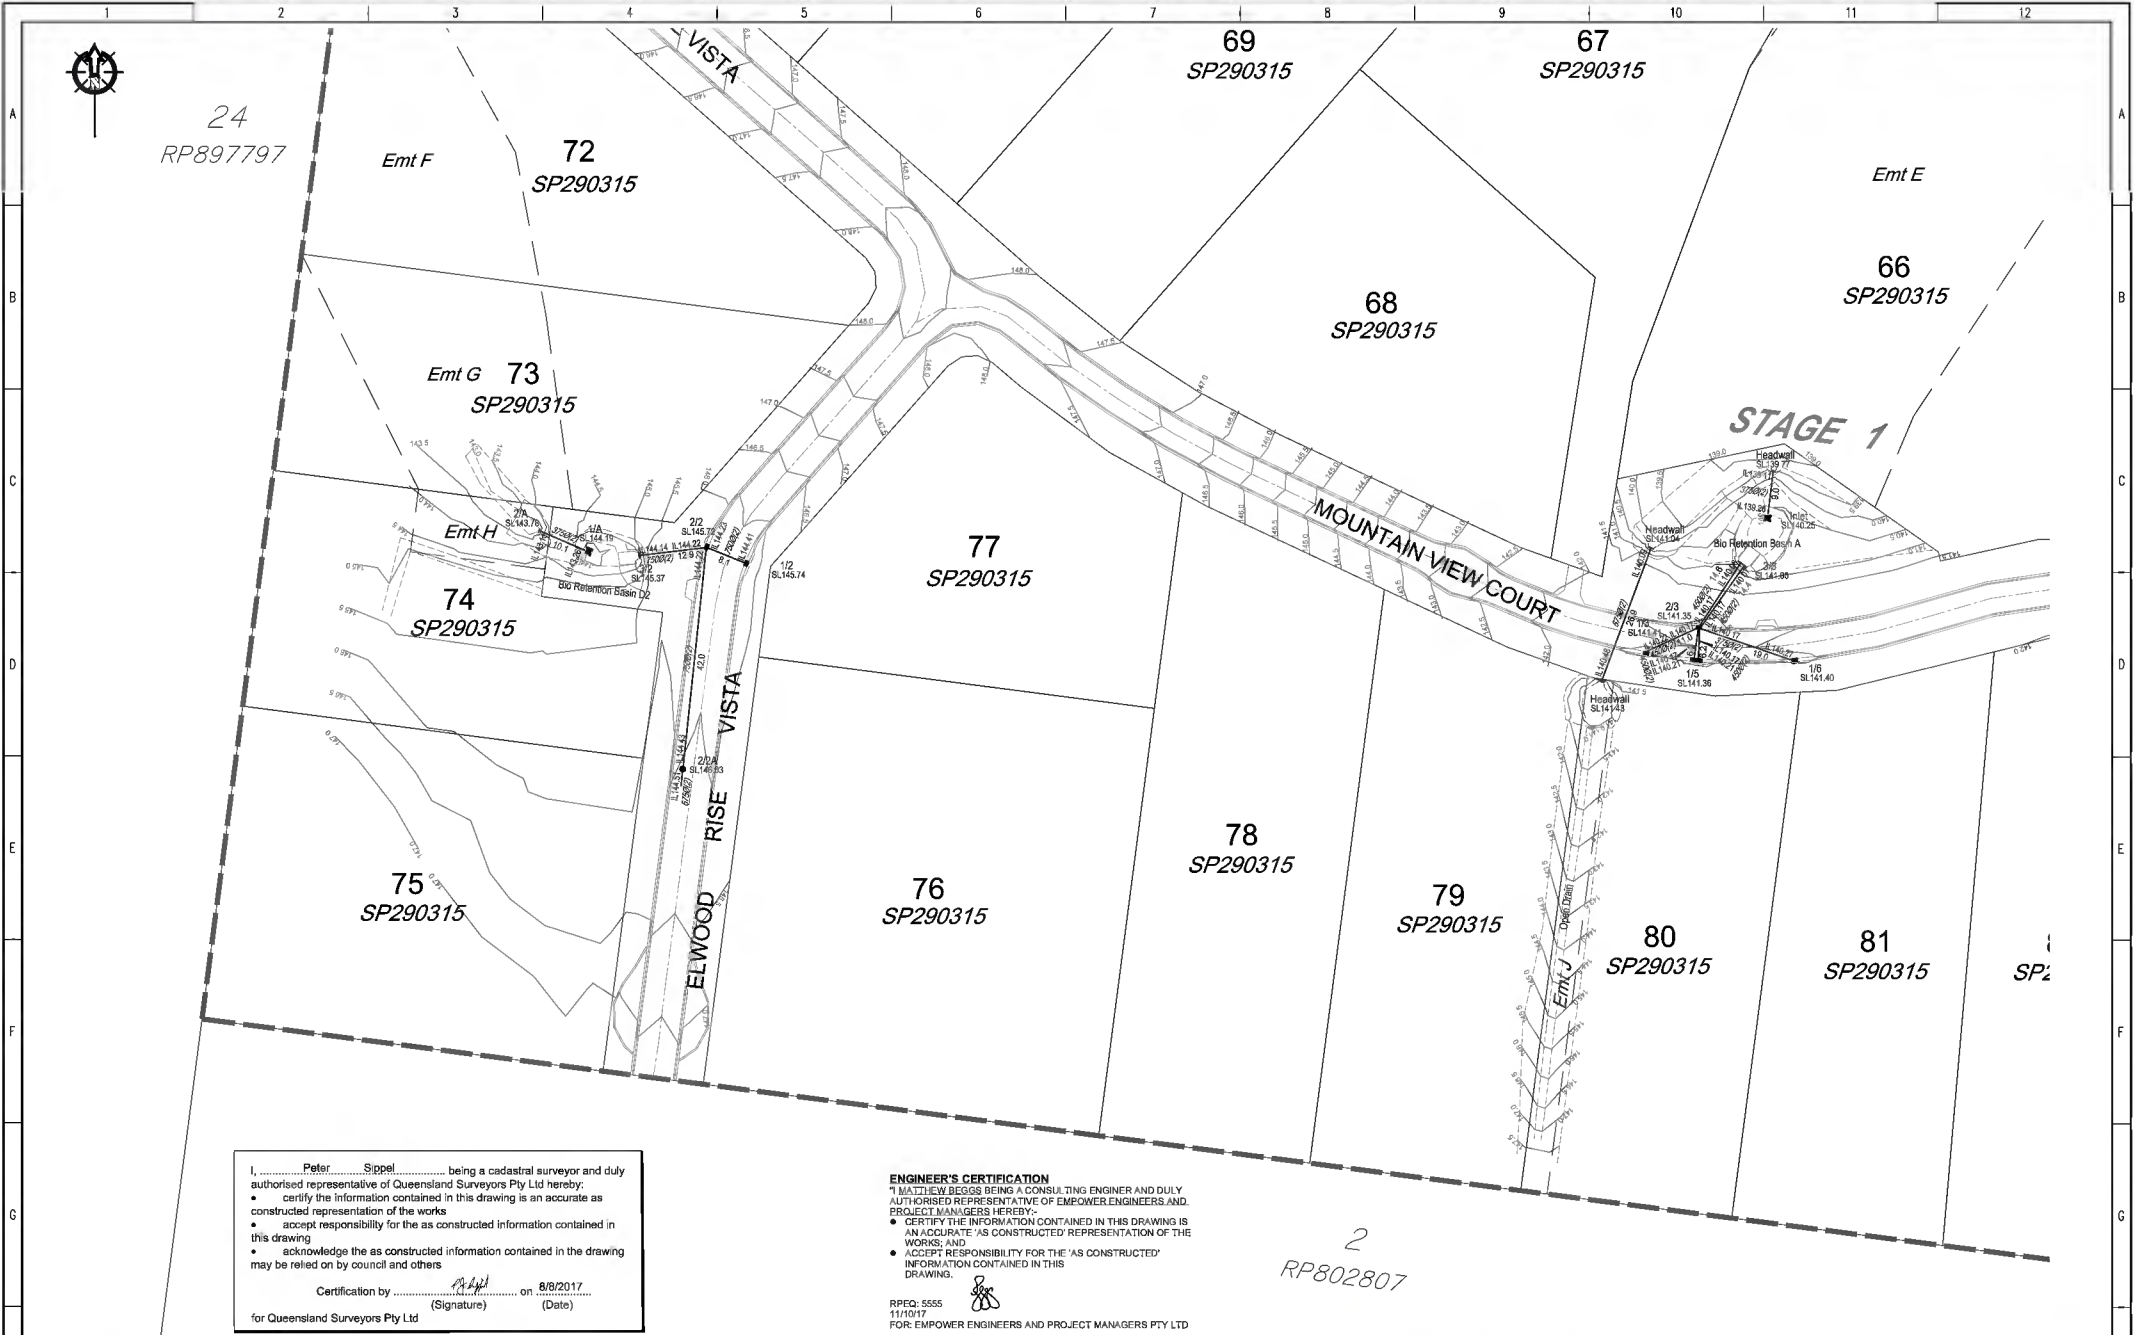

24
RP897797

69 SP290315 67 SP290315

Emt E

66 SP290315

Emt F 72 SP290315

68 SP290315

STAGE 1

Emt G 73 SP290315

77 SP290315

Emt H 74 SP290315

MOUNTAIN VIEW COURT

75 SP290315

76 SP290315

ELWOOD RISE VISTA

78 SP290315

79 SP290315

80 SP290315

81 SP290315

SP2

2
RP802807

I, Peter Sippl, being a cadastral surveyor and duly authorised representative of Queensland Surveyors Pty Ltd hereby:
 • certify the information contained in this drawing is an accurate as constructed representation of the works
 • accept responsibility for the as constructed information contained in this drawing
 • acknowledge the as constructed information contained in the drawing may be relied on by council and others
 Certification by [Signature] on 8/8/2017
 (Signature) (Date)
 for Queensland Surveyors Pty Ltd

ENGINEER'S CERTIFICATION
 I, MATTHEW BEGGS BEING A CONSULTING ENGINEER AND DULY AUTHORIZED REPRESENTATIVE OF EMPOWER ENGINEERS AND PROJECT MANAGERS HEREBY:
 • CERTIFY THE INFORMATION CONTAINED IN THIS DRAWING IS AN ACCURATE 'AS CONSTRUCTED' REPRESENTATION OF THE WORKS; AND
 • ACCEPT RESPONSIBILITY FOR THE 'AS CONSTRUCTED' INFORMATION CONTAINED IN THIS DRAWING.
 RPEQ: 5555
 11/10/17
 FOR: EMPOWER ENGINEERS AND PROJECT MANAGERS PTY LTD

DRAWING REVISIONS	
REV.	REVISION DESCRIPTION
A	Original

REFERENCE DRAWINGS	
DRG. No.	DESCRIPTION

DESIGN FILE No.	DESIGNED
CONSTRUCT. No.	DATE
31407 ASW01	EJM
	8/8/2017
LOG BOOK	EJM
CHECKED	
LEVEL DATUM	AHD
DATUM	DATE
	8/8/2017

THIS WORK WAS PREPARED BY:
QUEENSLAND SURVEYING PTY LTD
 SCALE 1:500 ORIGINAL SIZE A1

Moreton Bay Regional Council
MORSTON BAY REGIONAL COUNCIL
 CABOOLTURE DISTRICT OFFICE
 2 BASKING STREET CABOOLTURE QLD 4510
 PO BOX 159 CABOOLTURE QLD 4510
 Telephone: (07) 5433 8100
 Fax: (07) 5433 4099

STAGE 1, ELWOOD RISE, D'AUGILAR AS CONSTRUCTED STORMWATER

MORC SUBDIVISION REFERENCE	
ASCON GRID NUMBER	REV.
DA/29768/2015/V3RL	
No. 3 OF 3 PLANS	
31407-ASW01	A