



MONARO DRIVE  
Connection to existing main by Unitywater  
Ex.FH

25  
RP897797

37  
SP110043

REGISTERED SURVEYOR'S CERTIFICATION

We, Queensland Surveying Pty Ltd (ACN 604 671 374) Cadastral Surveyors, hereby certify that the vertical and horizontal locations and dimensions shown on this plan are a true and correct record and were located by survey.

6152 14/09/2017  
Delegate (signature) Registration ID Date

AS-CONSTRUCTED CERTIFICATION

I, Mattie Begg hereby certify that:  
1. The information contained in this drawing/document is in compliance with approved drawings and design.  
2. This represents an accurate record of as constructed works and I accept responsibility for the information contained in this drawing/document.

[Signature] RPEQ No. 5555 Date 15/9/2017  
RPEQ (signature)

LEGEND

- New Hydrant
- New Valve
- New End Cap
- New Taper
- New Water Service Conduit (Indicative)
- New Water Meter
- New Water House connection

24  
RP897797

Emt F

72  
SP290315

70  
SP290315

69  
SP290315

67  
SP290315

Emt E

66  
SP290315

Emt G  
73  
SP290315

68  
SP290315

STAGE 1

Emt H

74  
SP290315

77  
SP290315

MOUNTAIN VIEW COURT

78  
SP290315

79

75  
SP290315

OD RISE VISTA  
0150

76

A1

INDEX	DATE	REVISIONS	DRAWN	CHECKED	PASSED
B	14/09/2017	UPDATE	EM	EM	
A	28/07/2017	ORIGINAL	EM	EM	

DRAWN	EM	28/07/2017
CHECKED	EM	28/07/2017
PASSED	-	-
INITIALS		DATE



Unitywater

AS-CONSTRUCTED  
WATER RETICULATION  
STAGE 1, ELWOOD RISE, D'AUGILAR

SCALE 1:500

SHEET 1 OF 3 SHEETS

DRAWING NO.

31407-AW01



**REGISTERED SURVEYOR'S CERTIFICATION**  
 We, Queensland Surveying Pty Ltd (ACN 604 671 374) Cadastral Surveyors, hereby certify that the vertical and horizontal locations and dimensions shown on this plan are a true and correct record and were located by survey.


Delegate (signature) *M. J. J.* 6152 Registration ID Date 14/09/2017

**AS-CONSTRUCTED CERTIFICATION**  
 I, *Mattias Boggs*, hereby certify that:

- The information contained in this drawing/document is in compliance with approved drawings and design.
- This represents an accurate record of as constructed works and I accept responsibility for the information contained in this drawing/document.

RPEQ (signature) *M. Boggs* RPEQ No. 5555 Date 15/9/2017

- LEGEND**
- New Hydrant
  - New Valve
  - New End Cap
  - New Taper
  - New Water Service Conduit (Indicative)
  - New Water Meter
  - New Water House connection

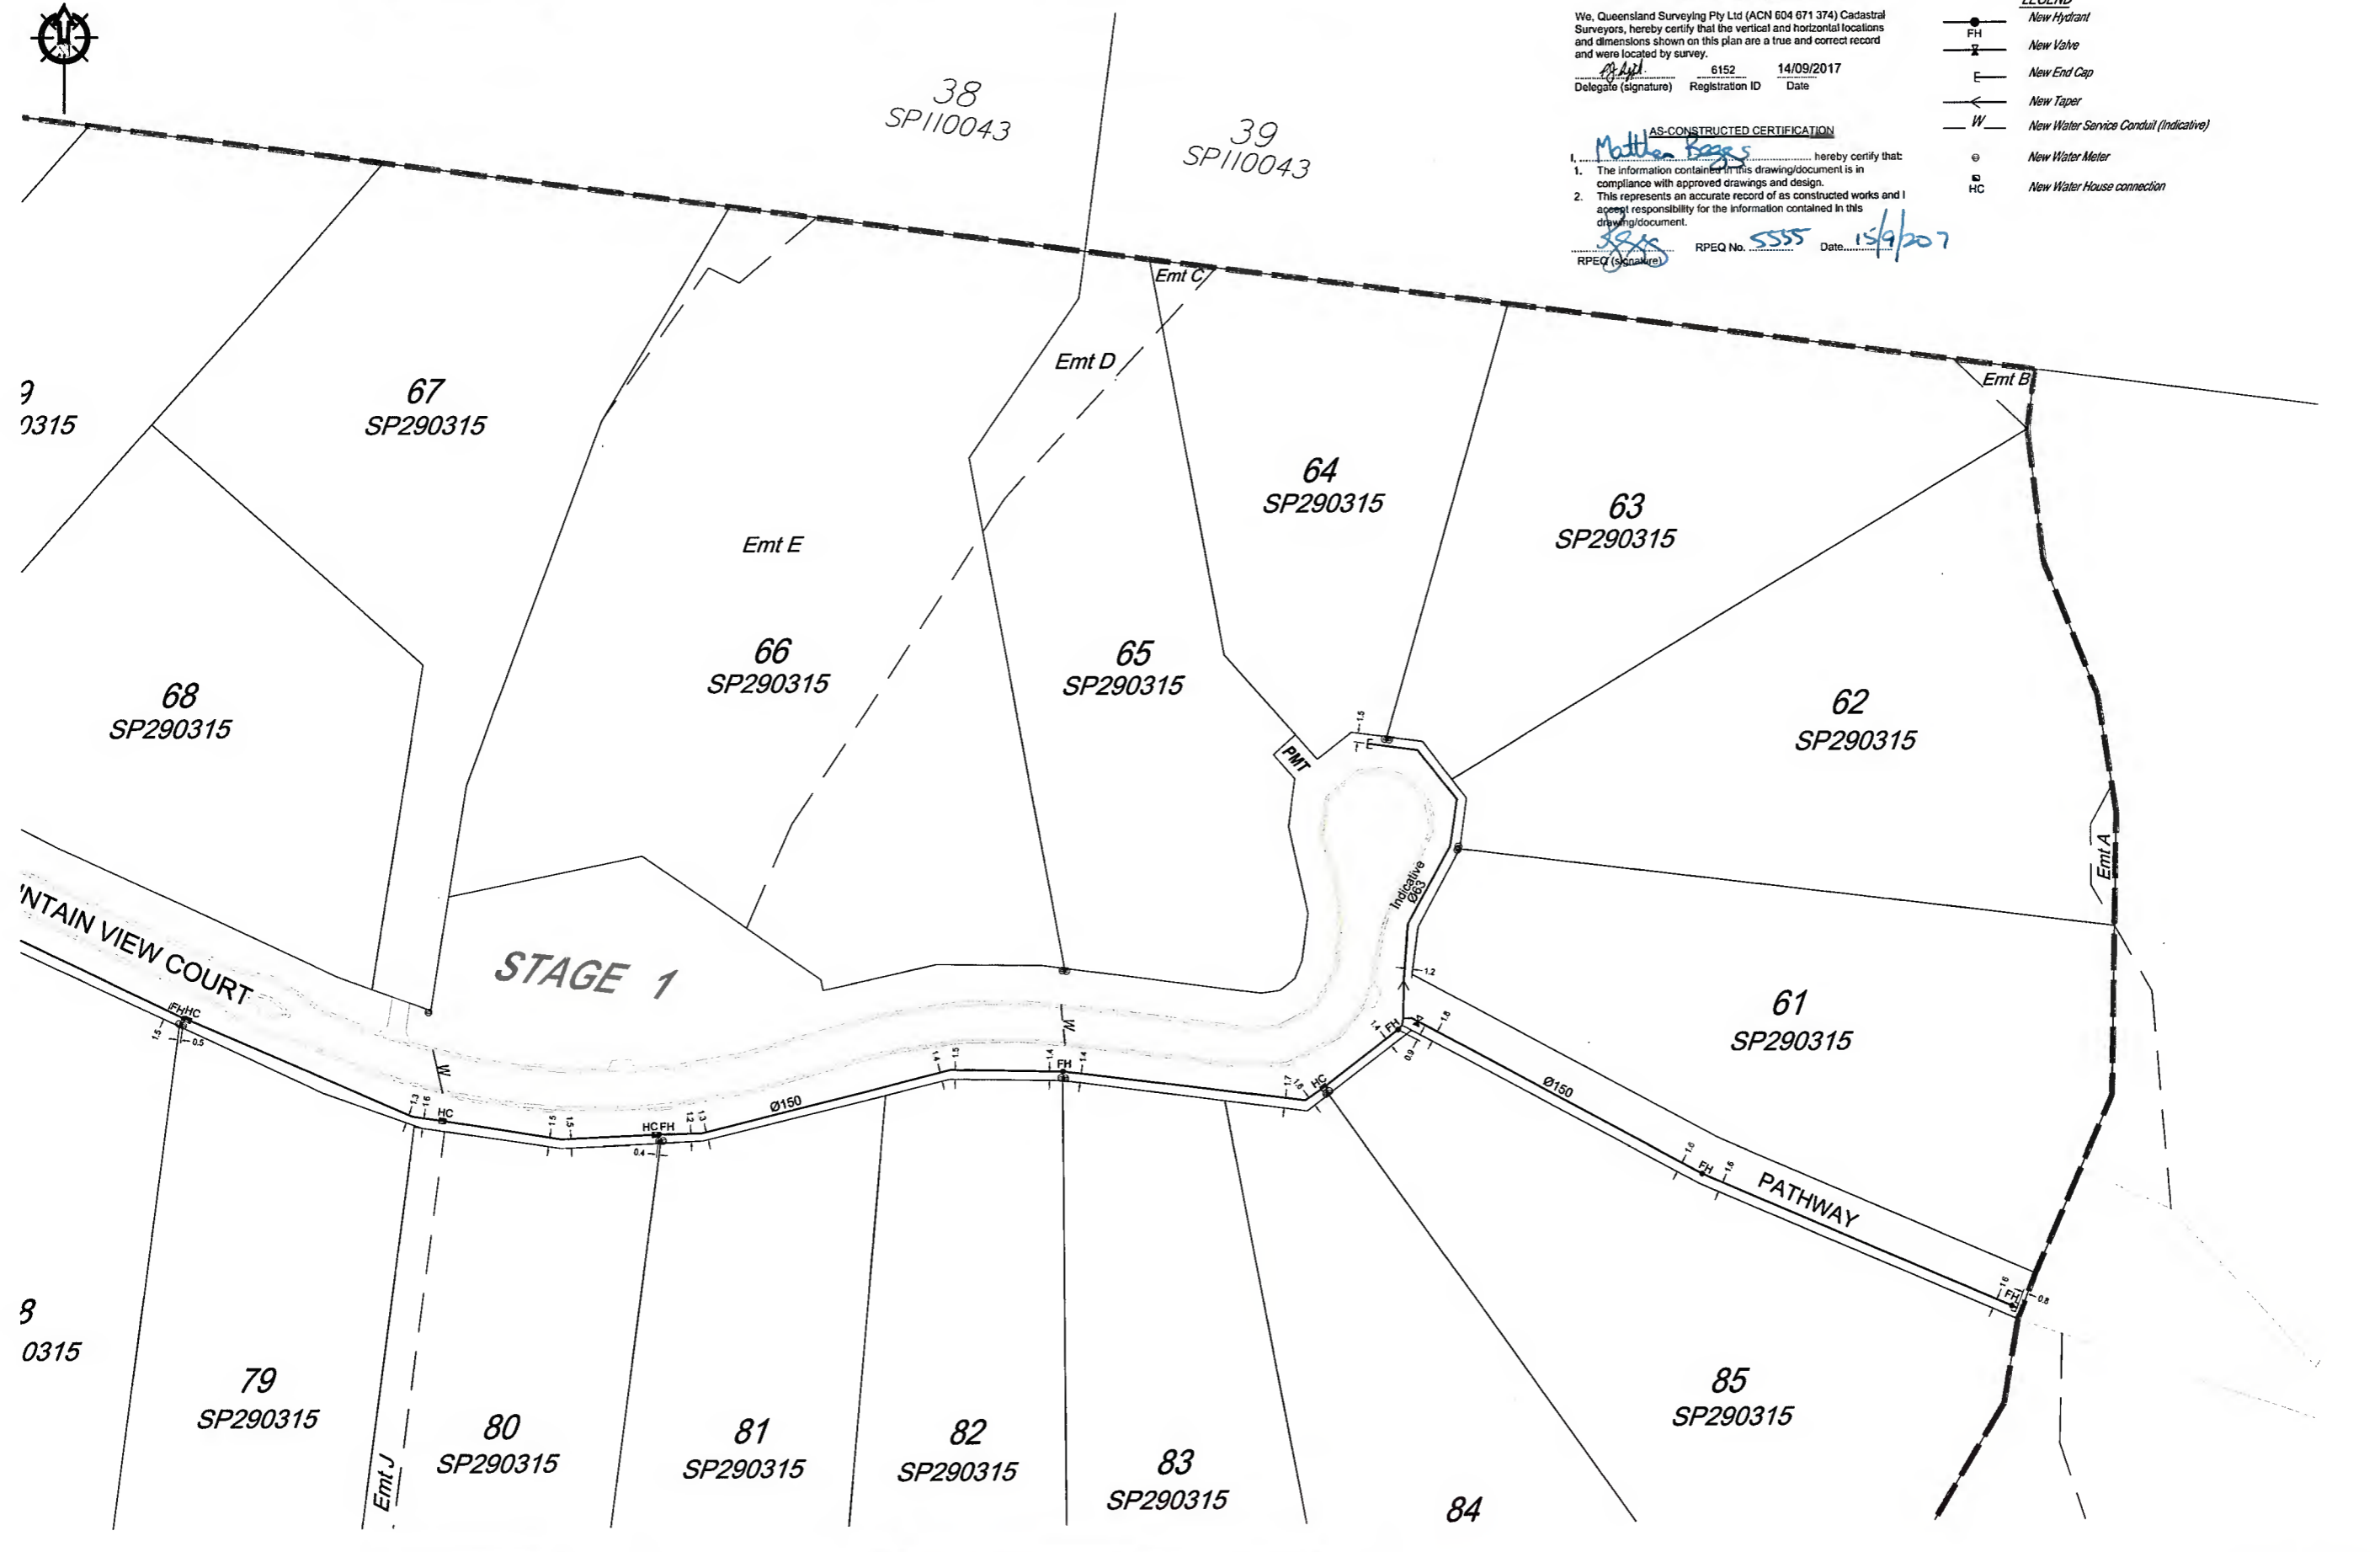

**A1**

INDEX	DATE	REVISIONS	DRAWN	CHECKED	PASSED
B	14/09/2017	UPDATE	EM	EM	
A	28/07/2017	ORIGINAL	EM	EM	

DRAWN	CHECKED	PASSED	INITIALS	DATE
EM	EM			28/07/2017
EM	EM			28/07/2017




Unitywater  
 AS-CONSTRUCTED  
 WATER RETICULATION  
 STAGE 1, ELWOOD RISE, D'AUGILAR

SCALE	15M
SHEET 2 OF 3	SHEETS
DRAWING NO.	31407-AW01



24  
RP897797

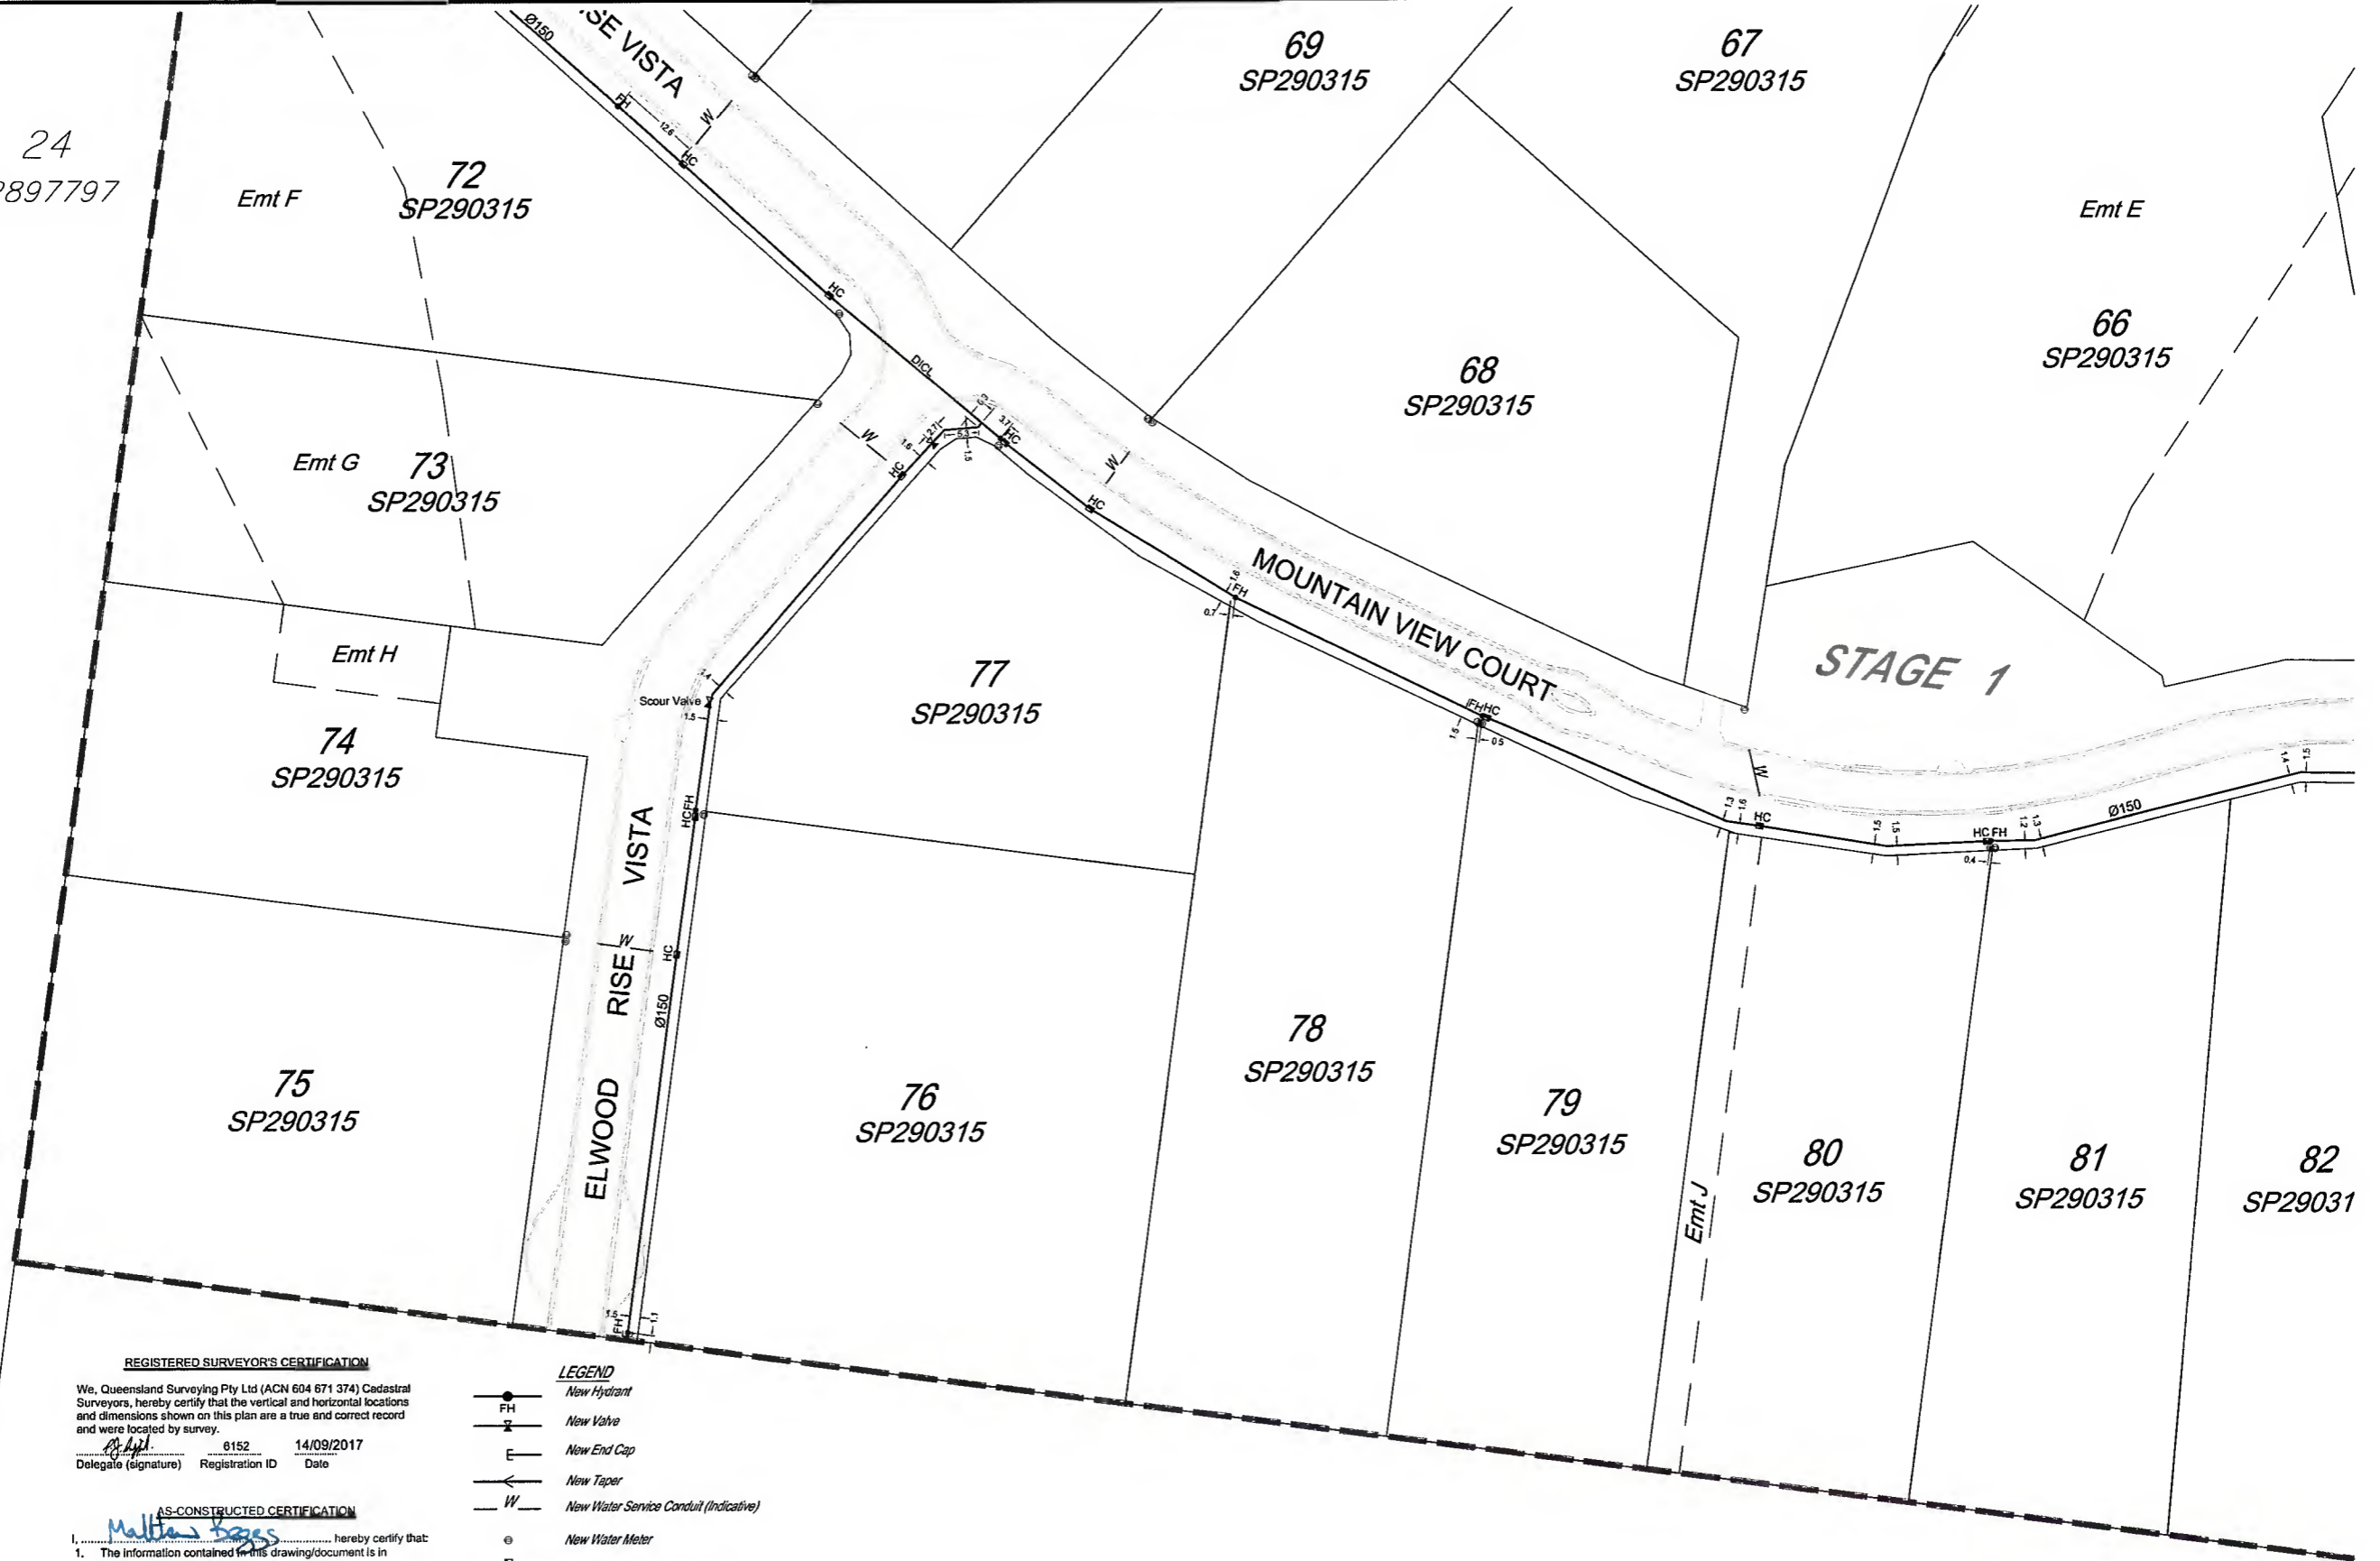

**REGISTERED SURVEYOR'S CERTIFICATION**

We, Queensland Surveying Pty Ltd (ACN 604 671 374) Cadastral Surveyors, hereby certify that the vertical and horizontal locations and dimensions shown on this plan are a true and correct record and were located by survey.

Delegate (signature) *[Signature]* Registration ID 6152 Date 14/09/2017

**AS-CONSTRUCTED CERTIFICATION**

1. *Mattias Boggs* hereby certify that the information contained in this drawing/document is in compliance with approved drawings and design.  
2. This represents an accurate record of as constructed works and I accept responsibility for the information contained in this drawing/document.

RPEQ (signature) *[Signature]* RPEQ No. 5555 Date 15/9/2017

- LEGEND**
- New Hydrant
  - New Valve
  - New End Cap
  - New Taper
  - New Water Service Conduit (Indicative)
  - New Water Meter
  - New Water House connection

A1

INDEX	DATE	REVISIONS	DRAWN	CHECKED	PASSED
B	14/09/2017	UPDATE	EM	EM	
A	28/07/2017	ORIGINAL	EM	EM	

DRAWN	EM	28/07/2017
CHECKED	EM	28/07/2017
PASSED	-	-
INITIALS		DATE



BRISBANE PROSERPINE  
MACKAY CARINS  
WE'RE CONNECTED  
ACN 604 671 374  
Queensland Surveying Pty. Ltd. a Trade Company



Unitywater

AS-CONSTRUCTED  
WATER RETICULATION  
STAGE 1, ELWOOD RISE, D'AUGLAR

SCALE 1:50  
SHEET 3 OF 3 SHEETS  
DRAWING NO.  
**31407-AW01**

2  
DRA