



MONARO DRIVE
Connection to existing main by Unitywater
Ex.FH

25
RP897797

37
SP110043

REGISTERED SURVEYOR'S CERTIFICATION

We, Queensland Surveying Pty Ltd (ACN 604 671 374) Cadastral Surveyors, hereby certify that the vertical and horizontal locations and dimensions shown on this plan are a true and correct record and were located by survey.

6152 14/09/2017
Delegate (signature) Registration ID Date

AS-CONSTRUCTED CERTIFICATION

I, Mattie Begg hereby certify that:
1. The information contained in this drawing/document is in compliance with approved drawings and design.
2. This represents an accurate record of as constructed works and I accept responsibility for the information contained in this drawing/document.

[Signature] RPEQ No. 5555 Date 15/9/2017
RPEQ (signature)

LEGEND

- New Hydrant
- New Valve
- New End Cap
- New Taper
- New Water Service Conduit (Indicative)
- New Water Meter
- New Water House connection

24
RP897797

Emt F

72
SP290315

70
SP290315

69
SP290315

67
SP290315

Emt E

66
SP290315

Emt G 73
SP290315

68
SP290315

STAGE 1

Emt H

74
SP290315

77
SP290315

MOUNTAIN VIEW COURT

78
SP290315

75
SP290315

76

79

OD RISE VISTA
0150

A1

INDEX	DATE	REVISIONS	DRAWN	CHECKED	PASSED
B	14/09/2017	UPDATE	EM	EM	
A	28/07/2017	ORIGINAL	EM	EM	

DRAWN	EM	28/07/2017
CHECKED	EM	28/07/2017
PASSED	-	-
INITIALS	DATE	



Unitywater

AS-CONSTRUCTED
WATER RETICULATION
STAGE 1, ELWOOD RISE, D'AUGILAR

SCALE 1:500
SHEET 1 OF 3 SHEETS


DRAWING NO.
31407-AW01



REGISTERED SURVEYOR'S CERTIFICATION
 We, Queensland Surveying Pty Ltd (ACN 604 671 374) Cadastral Surveyors, hereby certify that the vertical and horizontal locations and dimensions shown on this plan are a true and correct record and were located by survey.
 Delegate (signature) *M. J. J.* 6152 Registration ID Date 14/09/2017

- LEGEND**
- New Hydrant
 - New Valve
 - New End Cap
 - New Taper
 - New Water Service Conduit (Indicative)
 - New Water Meter
 - New Water House connection

AS-CONSTRUCTED CERTIFICATION
 I, *Mattias Boggs*, hereby certify that:
 1. The information contained in this drawing/document is in compliance with approved drawings and design.
 2. This represents an accurate record of as constructed works and I accept responsibility for the information contained in this drawing/document.
 RPEQ (signature) *M. Boggs* RPEQ No. 5555 Date 15/9/2017

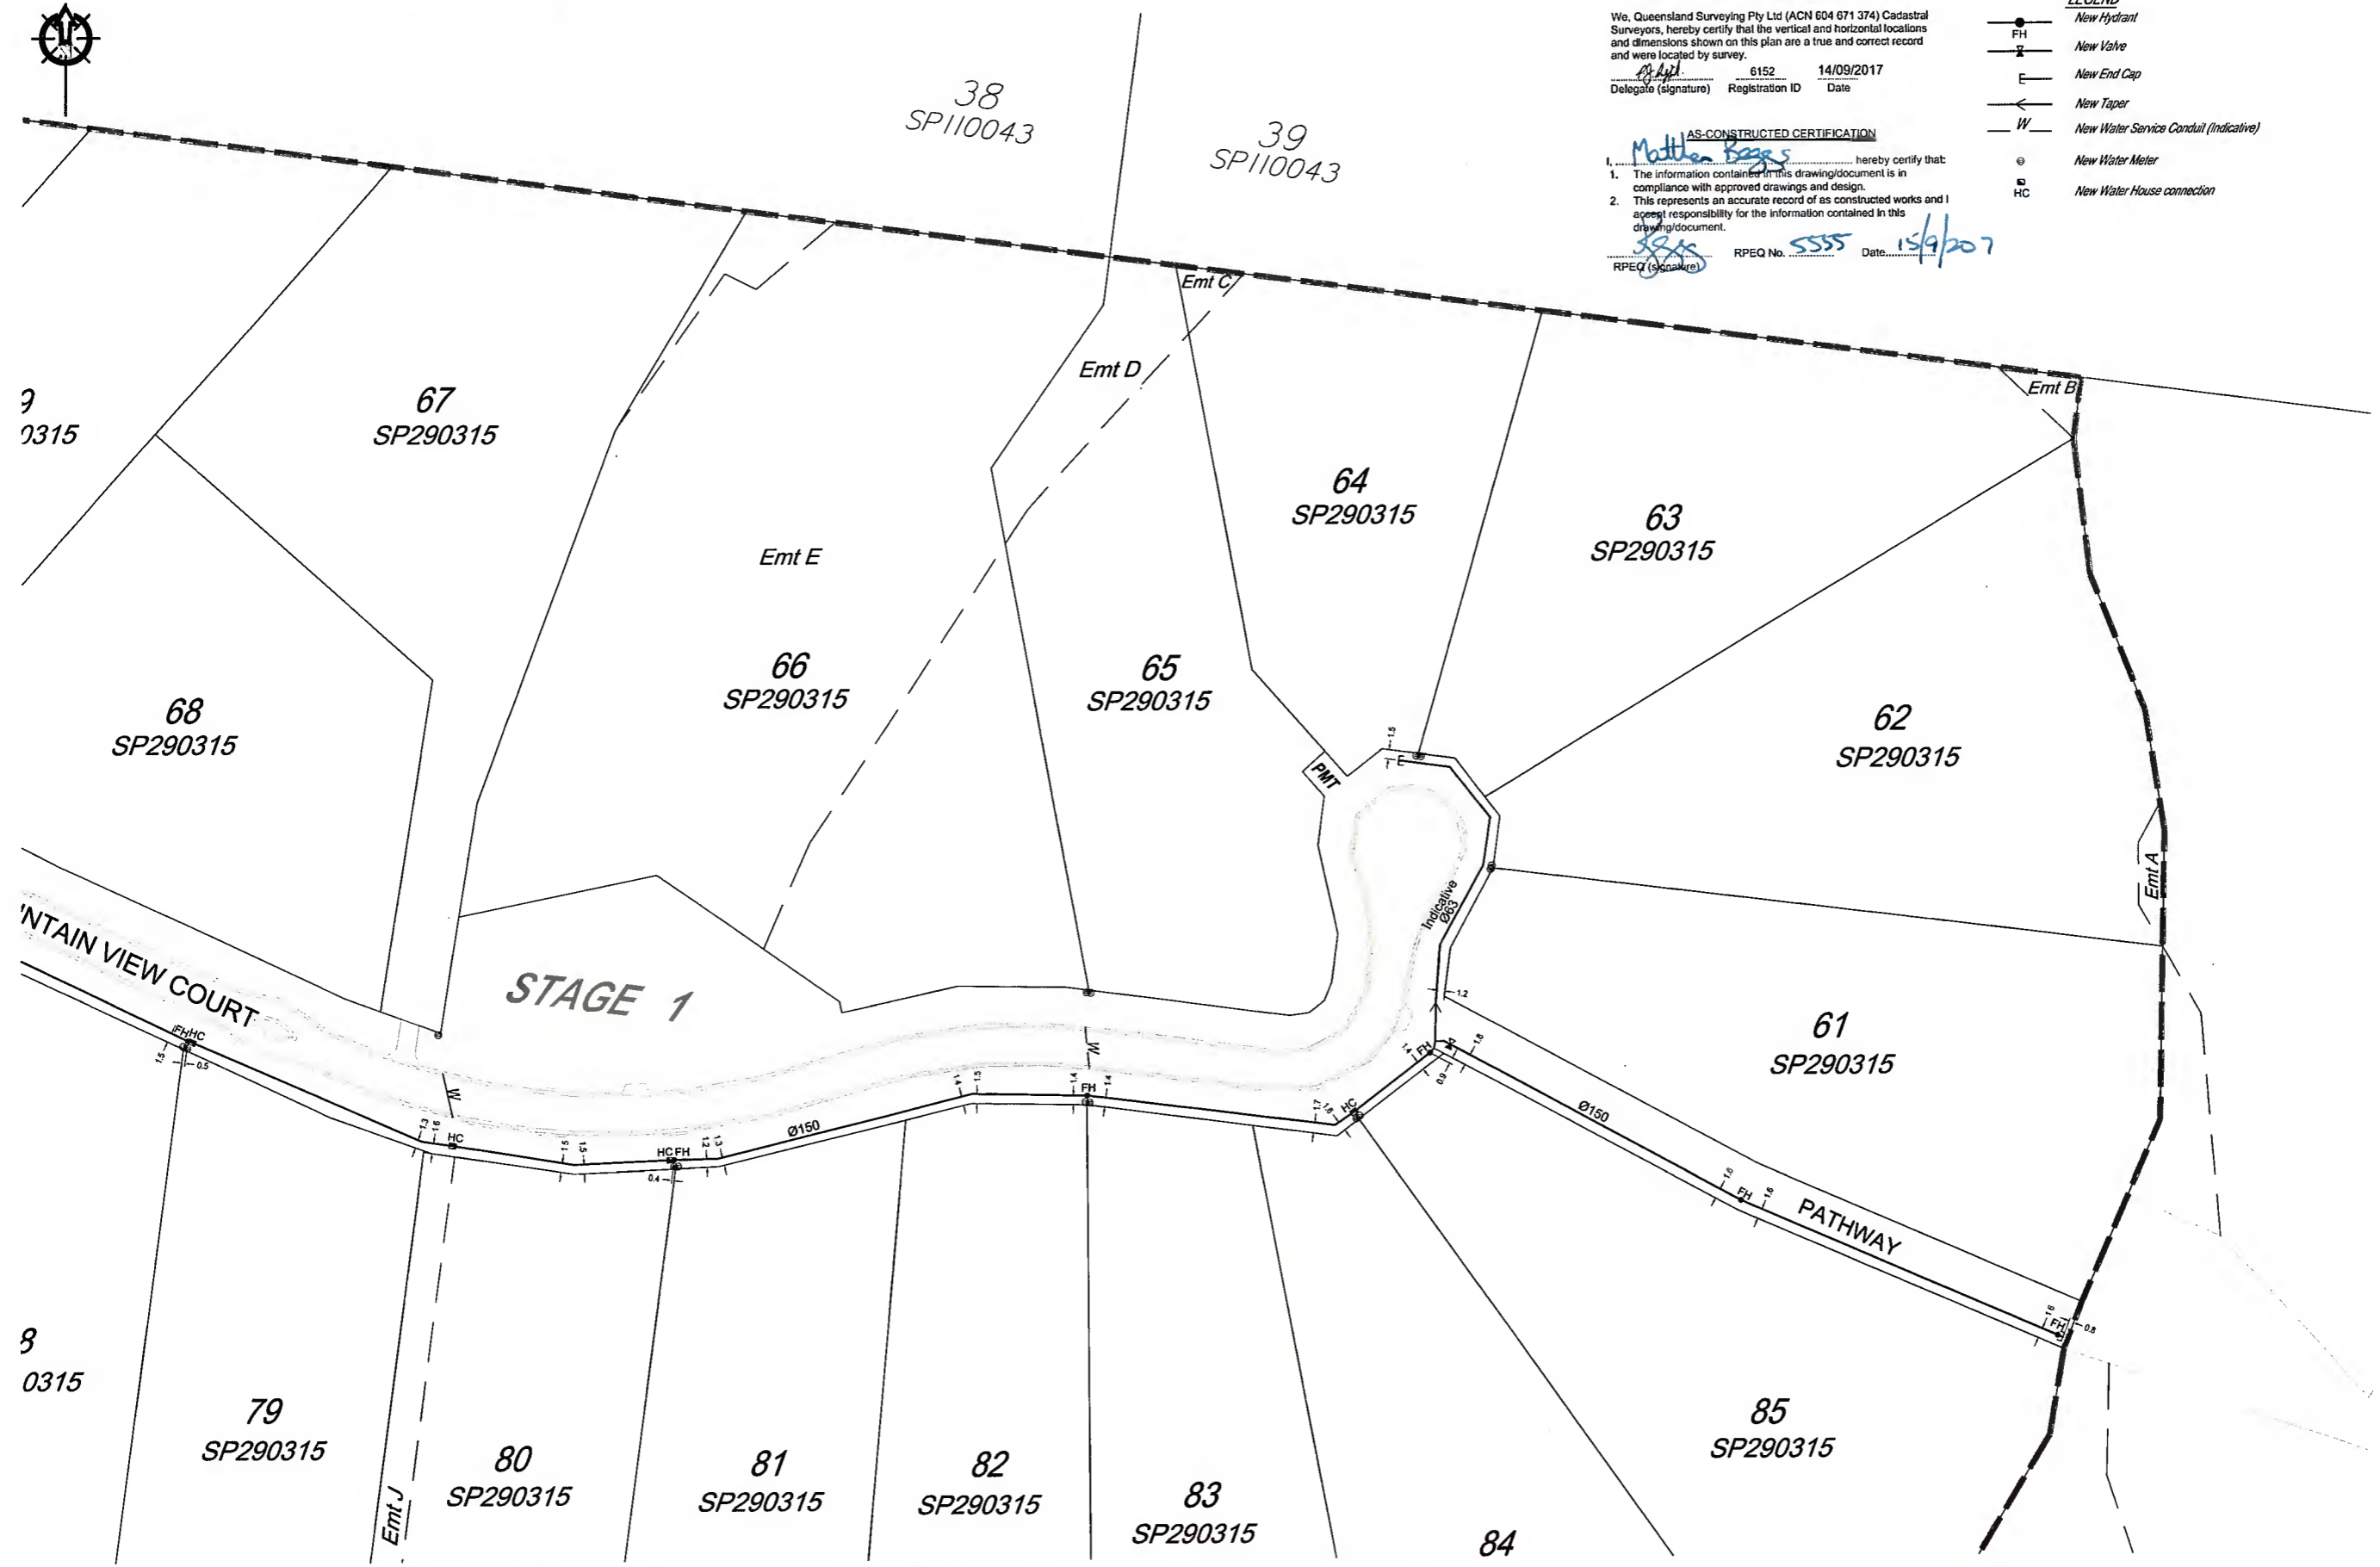

A1	INDEX	DATE	REVISIONS	DRAWN	CHECKED	PASSED
	B	14/09/2017	UPDATE	EM	EM	
	A	28/07/2017	ORIGINAL	EM	EM	

DRAWN	EM	28/07/2017
CHECKED	EM	28/07/2017
PASSED	-	-
INITIALS		DATE

veris
 BRISBANE PROSERPINE
 (07) 3904 4000 (07) 3904 1000
 MACKEY CAIRNS
 (07) 4041 2943 (07) 4041 8722
 VERIS.COM.AU
 ACN 504 671 374
 Queensland Surveying Pty Ltd is a Veris Company




Unitywater
 AS-CONSTRUCTED
 WATER RETICULATION
 STAGE 1, ELWOOD RISE, D'AUGILAR

SCALE	1:5M
SHEET 2 OF 3	SHEETS
DRAWING NO.	31407-AW01



24
RP897797

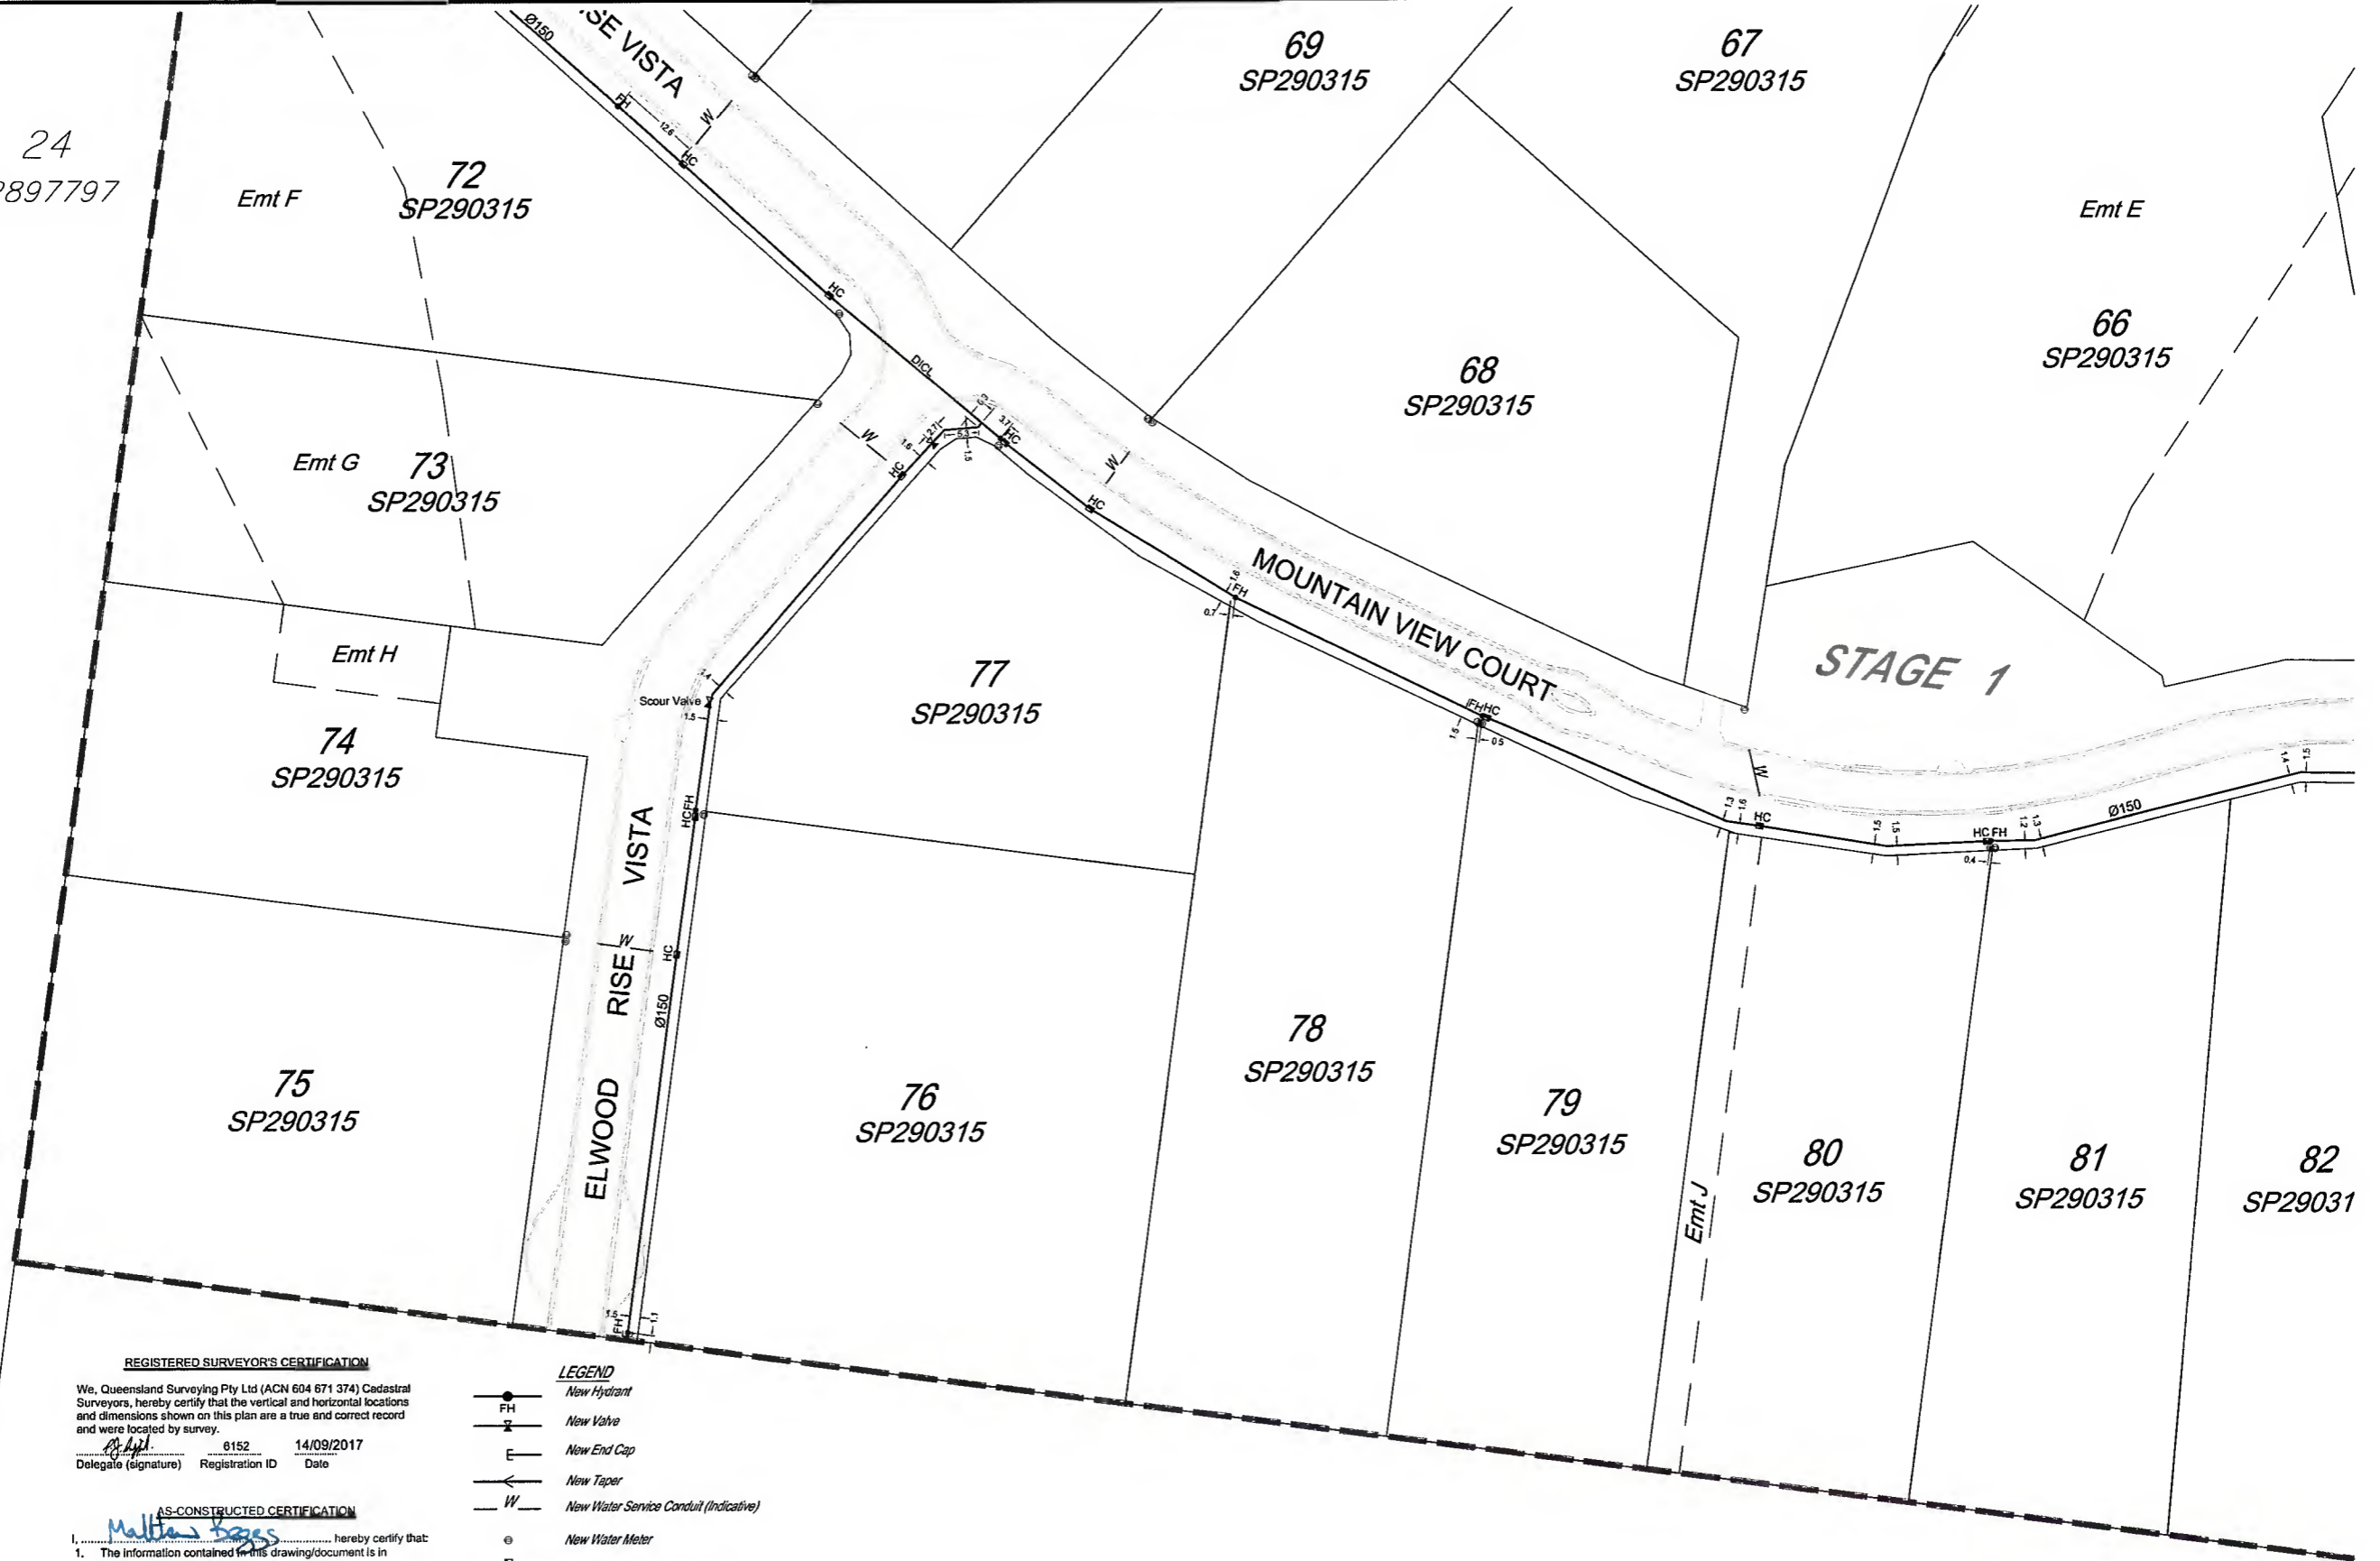

REGISTERED SURVEYOR'S CERTIFICATION

We, Queensland Surveying Pty Ltd (ACN 604 671 374) Cadastral Surveyors, hereby certify that the vertical and horizontal locations and dimensions shown on this plan are a true and correct record and were located by survey.

Delegate (signature) *[Signature]* Registration ID 6152 Date 14/09/2017

AS-CONSTRUCTED CERTIFICATION

1. *Mattias Boggs* hereby certify that the information contained in this drawing/document is in compliance with approved drawings and design.
2. This represents an accurate record of as constructed works and I accept responsibility for the information contained in this drawing/document.

RPEQ (signature) *[Signature]* RPEQ No. 5555 Date 15/9/2017

- LEGEND**
- New Hydrant
 - New Valve
 - New End Cap
 - New Taper
 - New Water Service Conduit (Indicative)
 - New Water Meter
 - New Water House connection

A1

INDEX	DATE	REVISIONS	DRAWN	CHECKED	PASSED
B	14/09/2017	UPDATE	EM	EM	
A	28/07/2017	ORIGINAL	EM	EM	

DRAWN	EM	28/07/2017
CHECKED	EM	28/07/2017
PASSED	-	-
INITIALS	DATE	



BRISBANE PROSERPINE
MACKAY CARINS
WATER.COM.AU
ACN 604 671 374
Queensland Surveying Pty. Ltd. a Trade Company



Unitywater

AS-CONSTRUCTED
WATER RETICULATION
STAGE 1, ELWOOD RISE, D'AUGLAR

SCALE 1:50
SHEET 3 OF 3 SHEETS
DRAWING NO.
31407-AW01

2
DRA